

STATE ENGINEER
Salem, Oregon

LINN Well Record

8623

STATE WELL NO. 11/4W-29K
COUNTY LINN
APPLICATION NO. GR-2858

OWNER: Lyle Truax


MAILING ADDRESS: 104 Clark County Court House

LOCATION OF WELL: Owner's No. #1

CITY AND STATE: Vancouver, Washington

NW $\frac{1}{4}$ SE $\frac{1}{4}$ Sec. 29 T. 11 N. S., R. 4 E. W., W.M.

Bearing and distance from section or subdivision corner S. 83° W. 40.2 chains from NE corner
of SE $\frac{1}{4}$ of Sec. 29, R. 11 S., R. 4 W.

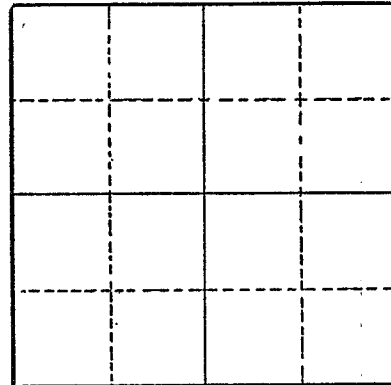

Section

Altitude at well

TYPE OF WELL: drilled Date Constructed 1948

Depth drilled 25 Depth cased 25

CASING RECORD:

12-inch

FINISH:

Slot perforations from 15 to 25

AQUIFERS:

WATER LEVEL:

12-feet

PUMPING EQUIPMENT: Type Gardner Denver 3" centrifugal H.P. 30
Capacity 500 G.P.M.

WELL TESTS:

Drawdown ft. after hours G.P.M.
Drawdown ft. after hours G.P.M.

USE OF WATER Irrigation Temp. °F., 19.....

SOURCE OF INFORMATION GR-2692

DRILLER or DIGGER Sloper

ADDITIONAL DATA:

Log Water Level Measurements Chemical Analysis Aquifer Test

REMARKS: