

STATE ENGINEER
Salem, Oregon

LINN
8624

Well Record

STATE WELL NO. 11/4W-29M
COUNTY Linn
APPLICATION NO. GR-1687

GR- 1637

OWNER: Paul Miller


MAILING ADDRESS: Rt. 4, Box 338

LOCATION OF WELL: Owner's No. #2

CITY AND STATE: Corvallis, Oregon

NW 1/4 SW 1/4 Sec. 29 T. 11 S., R. 4 W., W.M.

Bearing and distance from section or subdivision corner 29.5 ch. N. 16° 50' E. from SW cor. Sec. 29

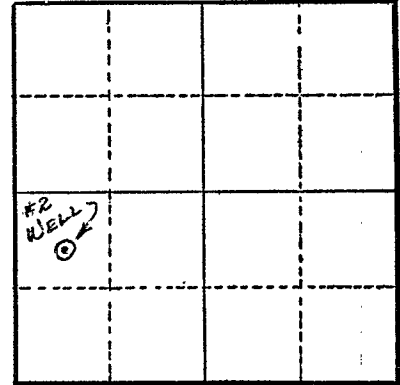

Section 29

Altitude at well 200'

TYPE OF WELL: Drilled Date Constructed 1952

Depth drilled 28' Depth cased 28'

CASING RECORD:
12"

FINISH:
Slot Perforations from 20 to 28 ft.

AQUIFERS:

WATER LEVEL:
12'

PUMPING EQUIPMENT: Type Peerless 4" Cent. H.P. 50
Capacity 800 G.P.M.

WELL TESTS:
Drawdown 4 ft. after 1000 hours G.P.M.
Drawdown ft. after hours G.P.M.

USE OF WATER Irrigation Temp. °F., 19
SOURCE OF INFORMATION GR Record
DRILLER or DIGGER Nicholas Klaus

ADDITIONAL DATA:
Log N.A. Water Level Measurements Chemical Analysis Aquifer Test

REMARKS:
Irrigation of 68.2 acres.