

STATE ENGINEER
Salem, Oregon

LINN
8625

Well Record

STATE WELL NO. 11/11/29M
COUNTY Linn
APPLICATION NO. GR-1686

GR- 1636

OWNER: Paul Miller


MAILING ADDRESS: Rt. 4, Box 338

LOCATION OF WELL: Owner's No. #1

CITY AND STATE: Corvallis, Oregon

NW 1/4 SW 1/4 Sec. 29 T. 11 S. R. 4 W., W.M.

Bearing and distance from section or subdivision corner 28 ch. N. 1°45' E. from SW cor. Sec. 29

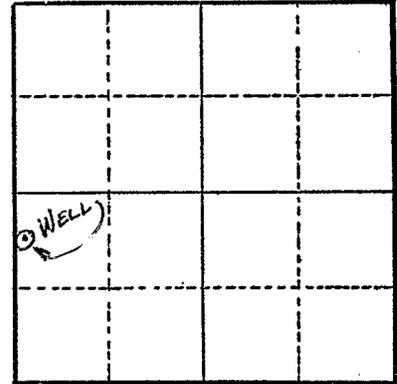

Section 29

Altitude at well 200'

TYPE OF WELL: Drilled Date Constructed 1955

Depth drilled 24' Depth cased 24'

CASING RECORD:
6"

FINISH:
Slot perforations from 18 to 24 ft.

AQUIFERS:

WATER LEVEL:
10'

PUMPING EQUIPMENT: Type 3" Cent. H.P. 10
Capacity 300 G.P.M.

WELL TESTS:
Drawdown ft. after hours G.P.M.
Drawdown ft. after hours G.P.M.

USE OF WATER Irrigation Temp. °F. 19

SOURCE OF INFORMATION GR Record

DRILLER or DIGGER Mr. Beck

ADDITIONAL DATA:
Log N.A. Water Level Measurements Chemical Analysis Aquifer Test

REMARKS:
Irrigation of 23.2 acres.