

STATE ENGINEER
Salem, Oregon

LINN
8629

Well Record

STATE WELL NO. 11/4W-30P(1)
COUNTY Linn
APPLICATION NO. GR-1099

GR- 1060

OWNER: Allison & Blacker Farms

MAILING
ADDRESS:

Rt. 4, Box 314

LOCATION OF WELL: Owner's No. #4


CITY AND
STATE:

Corvallis, Oregon

SE 1/4 SW 1/4 Sec. 30 T. 11 S., R. 4 W., W.M.

Bearing and distance from section or subdivision

corner 1940! N64°E. from SW cor. of Sec. 30.

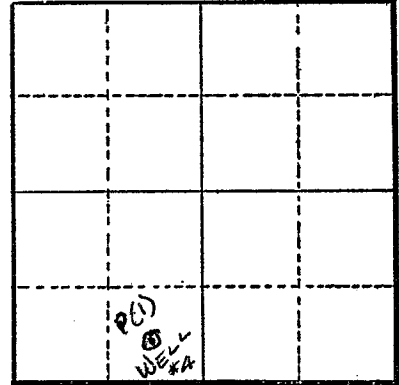

Section 30

Altitude at well 240 ft.

TYPE OF WELL: Drilled Date Constructed 1955

Depth drilled 30 ft. Depth cased 30 ft.

CASING RECORD:

10 inch

FINISH:

1/2 in. perforations - 15 per ft. from ??

AQUIFERS:

WATER LEVEL:

8 ft.

PUMPING EQUIPMENT: Type Cornell 3 in. H.P. 20

Capacity 500 G.P.M.

WELL TESTS:

Drawdown 4 ft. after 500 hours G.P.M.

Drawdown ft. after hours G.P.M.

USE OF WATER Irrigation Temp. °F. 19

SOURCE OF INFORMATION G. R. Record

DRILLER or DIGGER William Howell

ADDITIONAL DATA:

Log N.A. Water Level Measurements Chemical Analysis Aquifer Test

REMARKS:

Irrigation of 90 acres.