

STATE ENGINEER  
Salem, Oregon

# Well Record

STATE WELL NO. 11/4W-30R  
COUNTY Linn  
APPLICATION NO. GR- 1688

**LINN**  
**8630**

GR- 1638

OWNER: Paul Miller

MAILING  
ADDRESS:

Rt. 4, Box 338


LOCATION OF WELL: Owner's No. #3

CITY AND  
STATE:

Corvallis, Oregon

SE 1/4 SE 1/4 Sec. 30 T. 11 S., R. 4 W., W.M.

Bearing and distance from section or subdivision  
corner 11 ch. N. 42° 35' W. from SE cor. Sec. 30

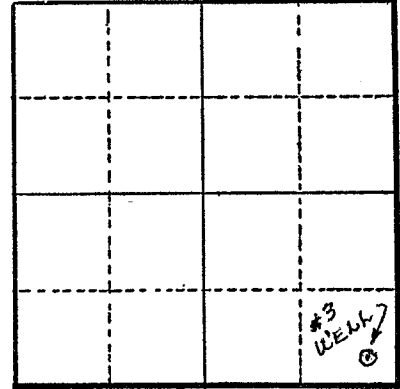

Section 30

Altitude at well 210'

TYPE OF WELL: Drilled Date Constructed 1952

Depth drilled 38' Depth cased 38'

CASING RECORD:

8"

FINISH:

Slot Perforations from 30 to 38 ft.

AQUIFERS:

WATER LEVEL:

25'

PUMPING EQUIPMENT: Type Western Land Roller Turbine H.P. 20

Capacity 350 G.P.M.

WELL TESTS:

Drawdown 10 ft. after \_\_\_\_\_ hours 400 G.P.M.

Drawdown \_\_\_\_\_ ft. after \_\_\_\_\_ hours \_\_\_\_\_ G.P.M.

USE OF WATER Irrigation Temp. \_\_\_\_\_ °F. \_\_\_\_\_, 19\_\_\_\_\_

SOURCE OF INFORMATION GR Record

DRILLER or DIGGER Nicholas Klaus

ADDITIONAL DATA:

Log N.A. Water Level Measurements \_\_\_\_\_ Chemical Analysis \_\_\_\_\_ Aquifer Test \_\_\_\_\_

REMARKS:

Irrigation of 49.8 acres.