

STATE ENGINEER
Salem, Oregon

LINN
8660

Well Record

STATE WELL NO. 11/4W-31D(1)
COUNTY Linn
APPLICATION NO. GR-1098

GR-1059

OWNER: Allison & Blacker Farms


MAILING ADDRESS: Rt. 4, Box 314

LOCATION OF WELL: Owner's No. #3

CITY AND STATE: Corvallis, Oregon

NW 1/4 NW 1/4 Sec. 31 T. 11 S., R. 4 W., W.M.

Bearing and distance from section or subdivision
corner 670' N79°W. to the NW cor. of Sec. 31.

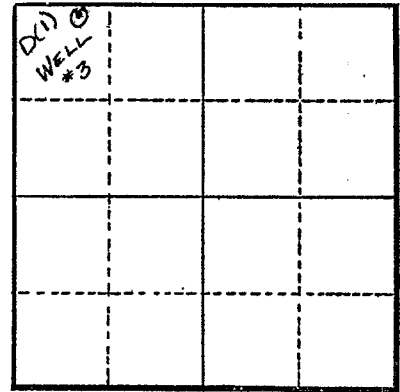

Section 31

Altitude at well 210 ft.

TYPE OF WELL: Drilled Date Constructed 1950

Depth drilled 30 ft. Depth cased 30 ft.

CASING RECORD:

10 inch

FINISH:

1/2 in. perforations - 20 per ft. from 25 to 30 ft.

AQUIFERS:

WATER LEVEL:

12 ft.

PUMPING EQUIPMENT: Type E. M. 2 in. H.P. 15
Capacity 400 G.P.M.

WELL TESTS:

Drawdown 5 ft. after 350 hours G.P.M.

Drawdown ft. after hours G.P.M.

USE OF WATER Irrigation Temp. °F., 19

SOURCE OF INFORMATION G. R. Record

DRILLER or DIGGER Frank Skillings

ADDITIONAL DATA:

Log N.A. Water Level Measurements Chemical Analysis Aquifer Test

REMARKS:

Irrigation of 80 acres.