

STATE ENGINEER
Salem, Oregon

LINN
8661

Well Record


STATE WELL NO. 11/4W-31L(1)
COUNTY Benton
APPLICATION NO. GR-285

OWNER: Bruce Brahs
MAILING ADDRESS: _____

LOCATION OF WELL: Owner's No. #2
CITY AND STATE: Corvallis, Oregon

NE 1/4 SW 1/4 Sec. 31 T. 11 S., R. 4 W., W.M.

Bearing and distance from section or subdivision
corner 862.1 feet N. 57° 57' W. from SE corner
DLC #87

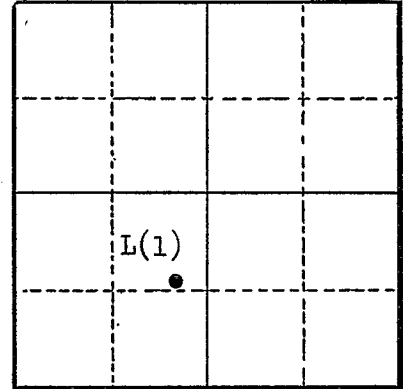

Section 31

Altitude at well 217' Interpolated

TYPE OF WELL: Drilled Date Constructed 1952

Depth drilled 38 Depth cased _____

CASING RECORD:
8" casing depth unknown

FINISH:
unknown

AQUIFERS:
Sand and gravel from 16 to 31 feet.

WATER LEVEL:
14 feet below land surface 6/29/56

PUMPING EQUIPMENT: Type Fairbanks - Morse 4-inch turbine H.P. 20
Capacity 500 G.P.M.

WELL TESTS:

Drawdown	13	ft. after	_____	hours	pumping	300	G.P.M.
Drawdown	11	ft. after	_____	hours	"	250	G.P.M.

USE OF WATER Irrigation 47.2 acres Temp. _____ °F., 19

SOURCE OF INFORMATION Registration Statement GR-285

DRILLER or DIGGER unknown

ADDITIONAL DATA:
Log yes Water Level Measurements _____ Chemical Analysis _____ Aquifer Test _____

REMARKS:

