

STATE ENGINEER
Salem, Oregon


LINN Well Record
8663

STATE WELL NO. 11/4W-31L(2)
COUNTY Benton
APPLICATION NO. GR-285

OWNER: Bruce Brahs MAILING ADDRESS:

LOCATION OF WELL: Owner's No. #3 CITY AND STATE: Corvallis, Oregon

NE 1/4 SW 1/4 Sec. 31 T. 11 S., R. 4 W., W.M.
Bearing and distance from section or subdivision
corner 1018 feet N 55° 36' W. of SE corner of
DLC #87

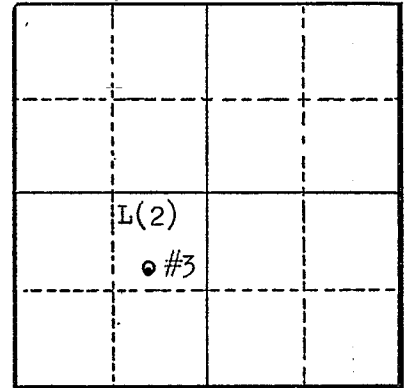

Section 31

Altitude at well 216 Interpolated

TYPE OF WELL: Drilled Date Constructed 1951

Depth drilled 21 Depth cased unknown

CASING RECORD:

4" casing - depth unknown

FINISH:

unknown

AQUIFERS:

unknown

WATER LEVEL:

unknown

PUMPING EQUIPMENT: Type New pump to be installed H.P.?
Capacity ? G.P.M.

WELL TESTS:

Drawdown ? ft. after ? hours G.P.M.
Drawdown ? ft. after ? hours G.P.M.

USE OF WATER Irrigation 47.2 acres Temp. °F., 19

SOURCE OF INFORMATION Registration Statement GR-285

DRILLER or DIGGER Raymond C. Gellatly Box 1, Philomath, Oregon

ADDITIONAL DATA:

Log No. Water Level Measurements Chemical Analysis Aquifer Test

REMARKS: