

STATE ENGINEER  
Salem, Oregon

LINN  
8664

# Well Record


STATE WELL NO. 11/4W-31P  
COUNTY LINN  
APPLICATION NO. GR-2538

OWNER: Hutoqua N. or Carl E. Linegar MAILING ADDRESS: Rt. 4, Box 327.

LOCATION OF WELL: Owner's No. #4 CITY AND STATE: Corvallis, Oregon

SE 1/4 SW 1/4 Sec. 31 T. 11 N S, R. 4 W, W.M.

Bearing and distance from section or subdivision corner S. 68° W. 1145' from SE corner DLC # 87

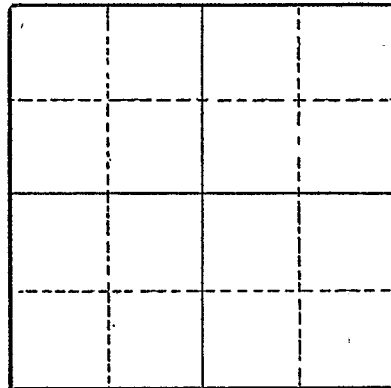

Section

Altitude at well

TYPE OF WELL: Drilled Date Constructed 1950

Depth drilled 32 Depth cased 32

### CASING RECORD:

14-inch

### FINISH:

### AQUIFERS:

Sand & gravel

### WATER LEVEL:

12 to 28-feet

PUMPING EQUIPMENT: Type Fairbanks Morse Centrifugal H.P. 10  
Capacity 350 G.P.M.

### WELL TESTS:

Drawdown 4 to 12 ft. after hours Pumping Over 400 G.P.M.

Drawdown ft. after hours G.P.M.

USE OF WATER Irrigation Temp. °F., 19

SOURCE OF INFORMATION GR-2398

DRILLER or DIGGER Frank Skillings, address unknown at this time

### ADDITIONAL DATA:

Log <sup>X</sup> Water Level Measurements Chemical Analysis Aquifer Test

### REMARKS:

Sand & gravel from top surface to bottom very similar for full depth.