

STATE ENGINEER
Salem, Oregon

LINN Well Record
8665


STATE WELL NO. 11/4W-31P(1)
COUNTY Benton
APPLICATION NO. GR-285

OWNER: Bruce Brahs
MAILING ADDRESS:

LOCATION OF WELL: Owner's No. #1
CITY AND STATE: Corvallis, Oregon

SE 1/4 SW 1/4 Sec. 31 T. 11 N. S., R. 4 W., W.M.

Bearing and distance from section or subdivision
corner 861.6' N 89° 46' W of SE corner of
DLC #87

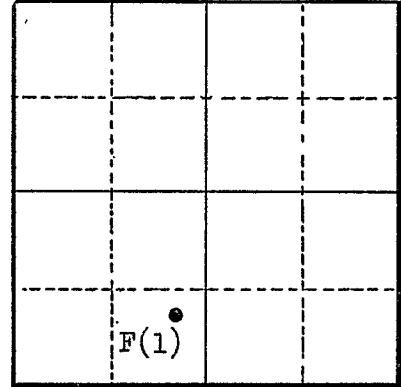

Section 31

Altitude at well 220' Interpolated

TYPE OF WELL: Drilled Date Constructed 1952

Depth drilled 28 Depth cased 28

CASING RECORD:

6" casing set from 0 to 28 feet

FINISH:

unknown

AQUIFERS:

unknown

WATER LEVEL:

14' below land surface - July 1956

PUMPING EQUIPMENT: Type Cornell centrifugal H.P. 10

Capacity 300 G.P.M.

WELL TESTS:

Drawdown 26 ft. after hours pumping 200 G.P.M.

Drawdown ft. after hours G.P.M.

USE OF WATER Irrigation 47.2 acres Temp. °F., 19

SOURCE OF INFORMATION Registration Statement GR-285

DRILLER or DIGGER Raymond C. Gellatly Box 1, Philomath, Oregon

ADDITIONAL DATA:

Log No. Water Level Measurements Chemical Analysis Aquifer Test

REMARKS: