

STATE ENGINEER
Salem, Oregon

LINN Well Record
8666


STATE WELL NO. 11/4W-31Q
COUNTY Linn
APPLICATION NO. GR-2119

OWNER: True E. Daniels
MAILING ADDRESS: Rt. 4, Box 327A

LOCATION OF WELL: Owner's No. _____
CITY AND STATE: Corvallis, Oregon

SW 1/4 SE 1/4 Sec. 31 T. 11 S., R. 4 W., W.M.

Bearing and distance from section or subdivision
corner N 61° 15' W 426' from SE corner DLC #87

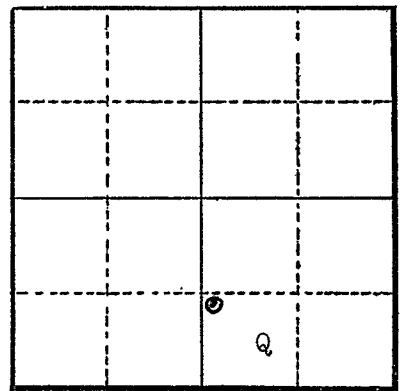

Section 31

Altitude at well _____

TYPE OF WELL: Dug Date Constructed 1952

Depth drilled 30' Depth cased 30'

CASING RECORD:

42-inch
18-inch

FINISH:

AQUIFERS:

WATER LEVEL:

13'

PUMPING EQUIPMENT: Type Cent. Cornell H.P. 3
Capacity 80 G.P.M.

WELL TESTS:

Drawdown _____ ft. after _____ hours _____ G.P.M.
Drawdown _____ ft. after _____ hours _____ G.P.M.

USE OF WATER Irrigation Temp. _____ °F. _____, 19____

SOURCE OF INFORMATION GR-3847

DRILLER or DIGGER _____

ADDITIONAL DATA:

Log NA Water Level Measurements _____ Chemical Analysis _____ Aquifer Test _____

REMARKS: