

STATE ENGINEER
Salem, Oregon

LINN
8667

Well Record

STATE WELL NO. 11/4W-310
COUNTY LINN
APPLICATION NO. GR-2120

OWNER: True E. Daniels


MAILING ADDRESS: Rt. 4 Box 327A

LOCATION OF WELL: Owner's No.

CITY AND STATE: Corvallis

SW 1/4 SE 1/4 Sec. 31 T. 11 S., R. 4 W., W.M.

Bearing and distance from section or subdivision corner S74° 30' W - 486 from SE corner DLC #87

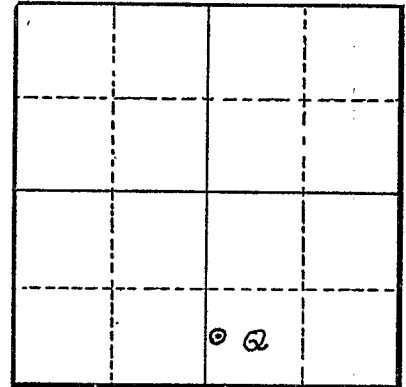

Section 31

Altitude at well

TYPE OF WELL: Dug Date Constructed NA

Depth drilled 30' Depth cased 30'

CASING RECORD:

42-inch

FINISH:

AQUIFERS:

WATER LEVEL:

13'

PUMPING EQUIPMENT: Type Cent. Cornell H.P. 3
Capacity 80 G.P.M.

WELL TESTS:

Drawdown ft. after hours G.P.M.
Drawdown ft. after hours G.P.M.

USE OF WATER Irrigation Temp. °F. 19

SOURCE OF INFORMATION GR-3848

DRILLER or DIGGER NA

ADDITIONAL DATA:

Log NA Water Level Measurements Chemical Analysis Aquifer Test

REMARKS: