


OWNER: Albert L. Gregory MAILING ADDRESS: Rt. 4, Box 333

LOCATION OF WELL: Owner's No. 2 CITY AND STATE: Corvallis, Oregon

SW $\frac{1}{4}$ SE $\frac{1}{4}$ Sec. 31 T. 11 N. S., R. 4 E. W., W.M.

Bearing and distance from section or subdivision corner S. 40° 15' E. 595.1 ft.

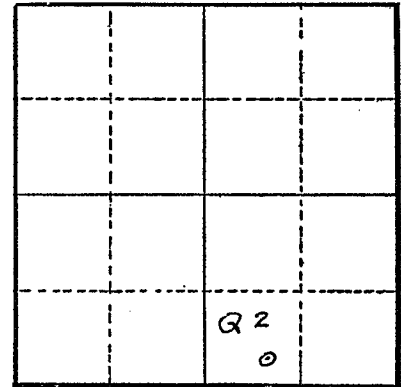

Section 31

Altitude at well 222 ft.

TYPE OF WELL: drilled Date Constructed prior 1955

Depth drilled 33 ft. Depth cased 33 ft.

CASING RECORD: 10 in. diameter steel 0 to 33 ft.

FINISH: Perf. $\frac{1}{4}$ in. slots in casing 15 to 33 ft.

AQUIFERS: coarse to fine gravel 15 to 33 ft.

WATER LEVEL: 18 ft. summer

PUMPING EQUIPMENT: Type Fairbanks Morse turbine H.P. 15 elec.
Capacity 275 G.P.M.

WELL TESTS:
Drawdown ft. after hours G.P.M.
Drawdown ft. after hours G.P.M.

USE OF WATER irrigation Temp. °F., 19.....

SOURCE OF INFORMATION owner

DRILLER or DIGGER

ADDITIONAL DATA:
Log X Water Level Measurements Chemical Analysis Aquifer Test

REMARKS: Log: Loam 0 to 8 ft.
Fine gravel 8 to 15 ft.
Coarse to fine gravel 15 to 33 ft.