

STATE ENGINEER
Salem, Oregon

LINN
8670

Well Record

STATE WELL NO. 11/LW-31R
COUNTY Linn
APPLICATION NO. GR-883

OWNER: Albert L. Gregory


MAILING ADDRESS: Rt. 4, Box 33

LOCATION OF WELL: Owner's No. 1

CITY AND STATE: Corvallis, Oregon

SE 1/4 SE 1/4 Sec. 31 T. 11 N. S., R. 4 E. W., W.M.

Bearing and distance from section or subdivision corner S. 88° 05' E. 967.3 ft. from SE cor. DLG 8?

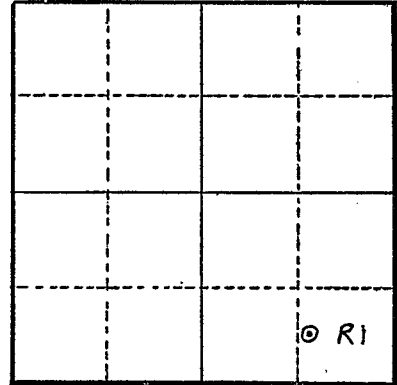

Altitude at well 220.6 ft.

Section 31

TYPE OF WELL: drilled Date Constructed prior 1955

Depth drilled 30 ft. Depth cased 30 ft.

CASING RECORD: 6 in. steel 0 to 30 ft.

FINISH:

AQUIFERS:

WATER LEVEL: 18 ft.

PUMPING EQUIPMENT: Type Fairbanks Morse centrifugal H.P. 15
Capacity 225 G.P.M.

WELL TESTS:

Drawdown ft. after hours G.P.M.

Drawdown ft. after hours G.P.M.

USE OF WATER irrigation Temp. °F. 19

SOURCE OF INFORMATION owner

DRILLER or DIGGER

ADDITIONAL DATA:

Log Water Level Measurements Chemical Analysis Aquifer Test

REMARKS: