

STATE ENGINEER
Salem, Oregon

LINN
8716

Well Record

GR- 1630

STATE WELL NO. 11/4W-32C
COUNTY Linn
APPLICATION NO. GR- 1689

OWNER: Paul Miller

MAILING
ADDRESS:

Rt. 4, Box 338

LOCATION OF WELL: Owner's No. #4


CITY AND
STATE:

Corvallis, Oregon

NE 1/4 NW 1/4 Sec. 32 T. 11 S., R. 4 W., W.M.

Bearing and distance from section or subdivision

corner 28.25 ch. S. 61° 50' E. from NW cor. of Sec. 32

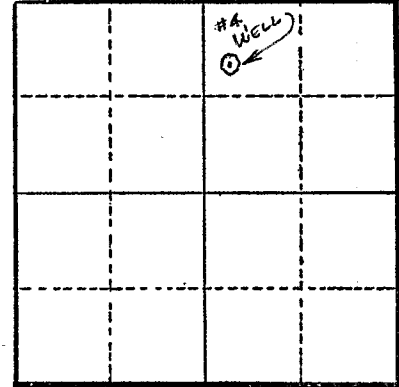

Section 32

Altitude at well 215'

TYPE OF WELL: Drilled Date Constructed 1952

Depth drilled 32' Depth cased 32'

CASING RECORD:

8"

FINISH:

Slot perforations from 24 to 32 ft.

AQUIFERS:

WATER LEVEL:

20'

PUMPING EQUIPMENT: Type Western Land Roller Turbine H.P. 25

Capacity 450 G.P.M.

WELL TESTS:

Drawdown 5 ft. after 500 hours G.P.M.

Drawdown ft. after hours G.P.M.

USE OF WATER Irrigation Temp. °F., 19

SOURCE OF INFORMATION GR Record

DRILLER or DIGGER Nicholas Klaus

ADDITIONAL DATA:

Log N.A. Water Level Measurements Chemical Analysis Aquifer Test

REMARKS:

Irrigation of 61.4 acres.