

STATE ENGINEER
Salem, Oregon

LINN
8719

Well Record

STATE WELL NO. 11/4W-32P(1)
COUNTY Linn
APPLICATION NO. GR-1105

GR- 1065

OWNER: Edgar and Viola McMorris

MAILING ADDRESS: Rt. 3, Box 791

LOCATION OF WELL: Owner's No.

CITY AND STATE: Albany, Oregon


SE 1/4 SW 1/4 Sec. 32 T. 11 S., R. 4 W., W.M.

Bearing and distance from section or subdivision corner 165' N. & 2838' W. of SE cor. Sec. 32.

Altitude at well 225 ft.

TYPE OF WELL: Dug Date Constructed 1946

Depth drilled 22 ft. Depth cased 22 ft.

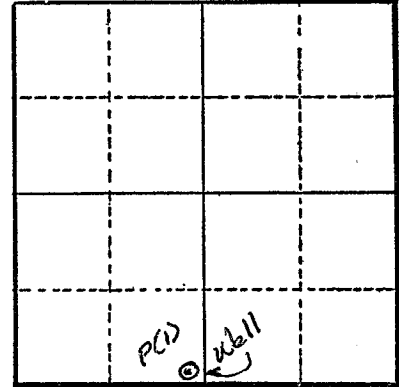

Section 32

CASING RECORD:

12 inch road culvert

FINISH:

Slot Perforations from 13 to 22 ft.

AQUIFERS:

WATER LEVEL:

3 ft.

PUMPING EQUIPMENT: Type 1 1/2 in. Cent. H.P. 3

Capacity 50 G.P.M.

WELL TESTS:

Drawdown 12 ft. after 50 hours G.P.M.

Drawdown ft. after hours G.P.M.

USE OF WATER Irrigation Temp. °F., 19

SOURCE OF INFORMATION G. R. Record

DRILLER or DIGGER Owner

ADDITIONAL DATA:

Log Water Level Measurements Chemical Analysis Aquifer Test

REMARKS:

Log: Clay	0 to 13 ft.
Medium gravel	13 to 21 ft.
Heavy rock	21 to 22 ft.

Irrigation of 7 acres.