

STATE ENGINEER  
Salem, Oregon

LINN  
8720

# Well Record

STATE WELL NO. 11/4W-32F  
COUNTY Linn  
APPLICATION NO. GR-4248


OWNER: Claude Barthall

MAILING  
ADDRESS: \_\_\_\_\_

LOCATION OF WELL: Owner's No. \_\_\_\_\_

CITY AND  
STATE: Mosier, Oregon

SE 1/4 NW 1/4 Sec. 32 T. 11 S., R. 4 N W., W.M.

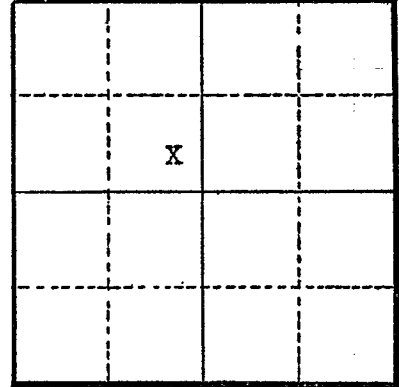

Bearing and distance from section or subdivision  
corner 3366' N. 2409' E. of SW Cor. Sec. 32

Section 32

Altitude at well \_\_\_\_\_

TYPE OF WELL: Drilled Date Constructed 1954

Depth drilled 38 ft. Depth cased 38 ft.

### CASING RECORD:

8 inch steel casing set to 38 feet

### FINISH:

Slot perforations from 28 to 38 feet

### AQUIFERS:

### WATER LEVEL:

6 feet below surface

PUMPING EQUIPMENT: Type Western Landroller turbine H.P. 30  
Capacity 700 G.P.M.

### WELL TESTS:

Drawdown 25 ft. after \_\_\_\_\_ hours 1000 G.P.M.  
Drawdown \_\_\_\_\_ ft. after \_\_\_\_\_ hours \_\_\_\_\_ G.P.M.

USE OF WATER Irrigation Temp. \_\_\_\_\_ °F., 19

SOURCE OF INFORMATION Well Registration Statement Cert. # GR-3783

DRILLER or DIGGER Jim Beck

### ADDITIONAL DATA:

Log \_\_\_\_\_ Water Level Measurements \_\_\_\_\_ Chemical Analysis \_\_\_\_\_ Aquifer Test \_\_\_\_\_

### REMARKS: