

STATE ENGINEER  
Salem, Oregon

LINN  
8748

# Well Record

STATE WELL NO. 11/LW-33C(1)  
COUNTY Linn  
APPLICATION NO. GR-98

OWNER: Twin Oaks Memorial Gardens, Inc.


MAILING ADDRESS: 405 West 1st Ave.

LOCATION OF WELL: Owner's No. 1

CITY AND STATE: Albany, Oregon

NE 1/4 NW 1/4 Sec. 33 T. 11 N. S., R. 4 E. W., W.M.

Bearing and distance from section or subdivision corner N. 49° 34' 45" W. 5061.0 ft. from SE cor. Wallace Cushman DLC Claim 67

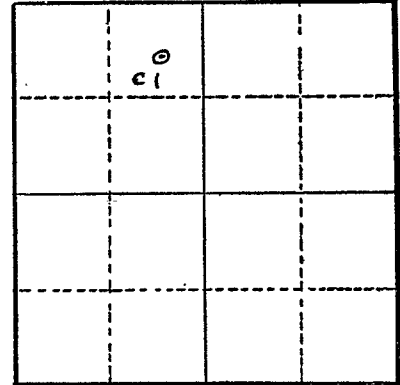

Section 33

Altitude at well 220 ft. Interpolated

TYPE OF WELL: drilled Date Constructed 4/1/55

Depth drilled 75 ft. Depth cased 65 ft.

CASING RECORD: 8 in. steel casing set from 0 to 65 ft.

FINISH: Perforations 8" x 1/4" in 6 rows from 52 to 64 ft.

AQUIFERS: Gravel from 43 to 64 ft.

WATER LEVEL: 43 ft. below land surface 4/12/55

PUMPING EQUIPMENT: Type #402 Berkeley 3" (single phase <sup>Motor</sup> Fairbanks Morse) H.P. 3  
Capacity G.P.M.

WELL TESTS:  
Drawdown 20 ft. after 30 hours G.P.M.  
Drawdown ft. after hours G.P.M.

USE OF WATER irrigation 9.65 acres Temp. °F. 19

SOURCE OF INFORMATION Reg. St. GR-98

DRILLER or DIGGER Claude Schaeffer; Philomath, Oregon

ADDITIONAL DATA:  
Log  Water Level Measurements  Chemical Analysis  Aquifer Test

REMARKS:

