

STATE ENGINEER
Salem, Oregon

LINN
8774 Well Record

STATE WELL NO. 11/4W-34N(1)
COUNTY Linn
APPLICATION NO. GR-499
G-1905

OWNER: John & Letha Glaser

MAILING
ADDRESS:


LOCATION OF WELL: Owner's No.

CITY AND
STATE:

Tangent, Oregon

SW 1/4 SW 1/4 Sec. 34 T. 11 N. S, R. 4 E. W., W.M.

Bearing and distance from section or subdivision
corner S. 42° W. 16.2 chs. from NW cor. Thomas
J. Anderson DIC 75

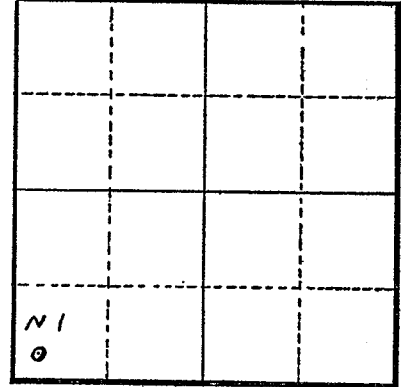

Section 34

Altitude at well

TYPE OF WELL: drilled Date Constructed 4/10/53

Depth drilled 165 ft. Depth cased 165 ft.

CASING RECORD: 8 inch

FINISH:

AQUIFERS:

WATER LEVEL:

PUMPING EQUIPMENT: Type Fairbanks Morse Pamona turbine H.P. 15
Capacity 700 G.P.M.

WELL TESTS:

Drawdown 50 ft. after hours 700 G.P.M.

Drawdown ft. after hours G.P.M.

USE OF WATER irrigation 100 acres Temp. °F. 19

SOURCE OF INFORMATION GR-499

DRILLER or DIGGER

ADDITIONAL DATA:

Log X Water Level Measurements Chemical Analysis Aquifer Test

REMARKS:

