

STATE ENGINEER  
Salem, Oregon

LINN  
8801

# Well Record

STATE WELL NO. 11/LW-36J(1)  
COUNTY Linn  
APPLICATION NO. GR-380

OWNER: George Van de Pol


MAILING ADDRESS: Rt. 4, Box 313

LOCATION OF WELL: Owner's No. 2

CITY AND STATE: Corvallis, Oregon

NE 1/4 SE 1/4 Sec. 36 T. 11 S., R. 4 W., W.M.

Bearing and distance from section or subdivision  
corner S. 34° 50' E. 45 chs. from NW cor. Charles  
Mulkey DLC 69

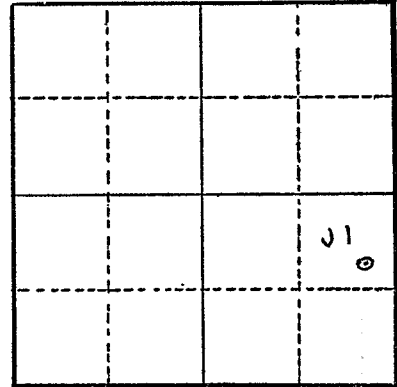

Altitude at well 215 ft.

TYPE OF WELL: drilled Date Constructed 5/19/52

Depth drilled 32 ft. Depth cased 32 ft.

Section 36

CASING RECORD: 10 in.

FINISH:

AQUIFERS:

WATER LEVEL: 18 ft.

PUMPING EQUIPMENT: Type Gould 2" centrifugal H.P. 15  
Capacity 300 G.P.M.

WELL TESTS:  
Drawdown ..... ft. after ..... hours ..... G.P.M.  
Drawdown ..... ft. after ..... hours ..... G.P.M.

USE OF WATER irrigation 29.6 acres Temp. ..... °F. ...., 19.....

SOURCE OF INFORMATION GR-380  
DRILLER or DIGGER Gellatney & Shafer; Philomath, Oregon

ADDITIONAL DATA:  
Log ..... Water Level Measurements ..... Chemical Analysis ..... Aquifer Test .....

REMARKS: