

STATE ENGINEER  
Salem, Oregon

LINN  
8826

# Well Record

STATE WELL NO. 11/5W-36A(1)  
COUNTY Linn  
APPLICATION NO. GR-1097

GR- 1058

OWNER: Allison & Blacker Farms


MAILING ADDRESS: Rt. 4, Box 314

LOCATION OF WELL: Owner's No. #2

CITY AND STATE: Corvallis, Oregon

NE 1/4 NE 1/4 Sec. 36 T. 11 S., R. 5 W., W.M.

Bearing and distance from section or subdivision corner 340' N35°W. to the NE cor. of Sec. 36.

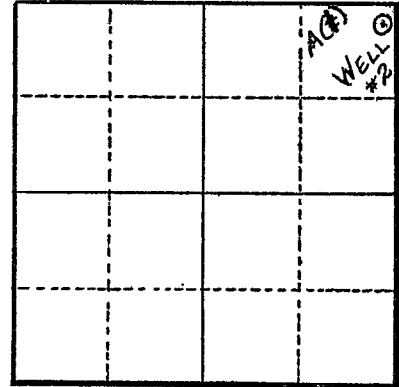

Section 36

Altitude at well 220 ft.

TYPE OF WELL: Dug Date Constructed 1942

Depth drilled 20 ft. Depth cased 20 ft.

CASING RECORD:  
18 inch concrete

FINISH:

AQUIFERS:

WATER LEVEL:  
6 ft.

PUMPING EQUIPMENT: Type Gardner-Denver 1 in. H.P. 3  
Capacity 80 G.P.M.

WELL TESTS:  
Drawdown 5 ft. after 100 hours G.P.M.  
Drawdown ft. after hours G.P.M.

USE OF WATER Irrigation & distilling Temp. °F. 19

SOURCE OF INFORMATION G. R. Record

DRILLER or DIGGER

ADDITIONAL DATA:

Log Water Level Measurements Chemical Analysis Aquifer Test

REMARKS:

Log: Soil 0 to 8 ft.  
Gravel 8 to 20 ft.

Irrigation of 15 acres.