

STATE ENGINEER
Salem, Oregon

LINN
8827

Well Record

STATE WELL NO. 11/5W-36(1)
COUNTY Linn
APPLICATION NO. GR-1096

GR- 1057

OWNER: Allison & Blacker Farms


MAILING ADDRESS: Rt. 4, Box 314

LOCATION OF WELL: Owner's No. #1

CITY AND STATE: Corvallis, Oregon

NE 1/4 NE 1/4 Sec. 36 T. 11 S., R. 5 W., W.M.

Bearing and distance from section or subdivision corner 1410' N. 22° E. to the NE cor. of Sec. 36.

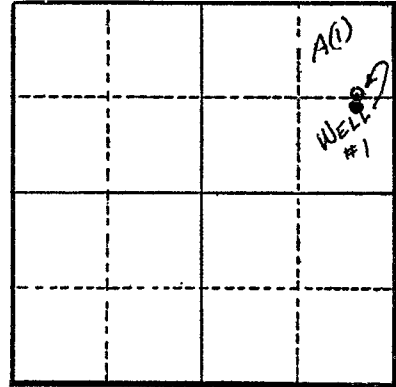

Section 36

Altitude at well 230 ft.

TYPE OF WELL: Drilled Date Constructed 1950

Depth drilled 30 ft. Depth cased 30 ft.

CASING RECORD:

10 inch

FINISH:

1/2 in. perforations - 20 per ft. from 25 to 30 ft.

AQUIFERS:

WATER LEVEL:

15 ft.

PUMPING EQUIPMENT: Type Pacific 3 in. Cent. H.P. 15

Capacity 400 G.P.M.

WELL TESTS:

Drawdown 8 ft. after 350 hours G.P.M.

Drawdown ft. after hours G.P.M.

USE OF WATER Irrigation Temp. °F. 19

SOURCE OF INFORMATION G. R. Record

DRILLER or DIGGER Frank Skillings

ADDITIONAL DATA:

Log N.A. Water Level Measurements Chemical Analysis Aquifer Test

REMARKS:

Irrigation of 35 acres.