

STATE ENGINEER
Salem, Oregon

LINN
8828

Well Record

GR- 1670


STATE WELL NO. 11/5W-36H
COUNTY Linn
APPLICATION NO. GR-1721

OWNER: Robert E. Taylor MAILING ADDRESS: Rt. 4, Box 319

LOCATION OF WELL: Owner's No. #1 CITY AND STATE: Corvallis, Oregon

SE 1/4 NE 1/4 Sec. 36 T. 11 S., R. 5 W., W.M.

Bearing and distance from section or subdivision corner 600' N. & 1045' W. from E¹/₄ cor. Sec. 36

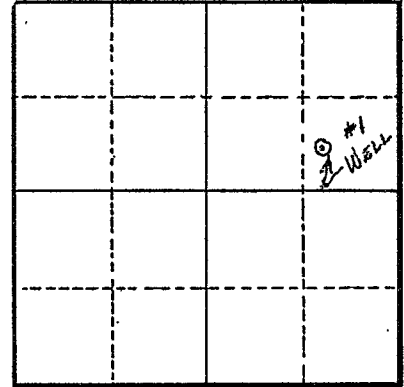

Section 36

Altitude at well 220'

TYPE OF WELL: Drilled Date Constructed 1938

Depth drilled 38' Depth cased 38'

CASING RECORD:
4"

FINISH:

Perforated from 30 to 38 ft.

AQUIFERS:

WATER LEVEL:

10'

PUMPING EQUIPMENT: Type 3" x 2 1/2" Cent. H.P. 35

Capacity 350 G.P.M.

WELL TESTS:

Drawdown ft. after hours G.P.M.

Drawdown ft. after hours G.P.M.

USE OF WATER Irrigation Temp. °F., 19

SOURCE OF INFORMATION GR Record

DRILLER or DIGGER Frank Skillings

ADDITIONAL DATA:

Log N.A. Water Level Measurements Chemical Analysis Aquifer Test

REMARKS:

Irrigation of 18 acres.