

STATE ENGINEER
Salem, Oregon

LINN
8829

Well Record

GR- 1618

STATE WELL NO. 11/5W-36J
COUNTY Linn
APPLICATION NO. GR- 1667

OWNER: Robert & Pauline Beach


MAILING ADDRESS: Rt. 4

LOCATION OF WELL: Owner's No. #2

CITY AND STATE: Corvallis, Oregon

NE 1/4 SE 1/4 Sec. 36 T. 11 S., R. 5 W., W.M.

Bearing and distance from section or subdivision corner 27.5 ch. N.26°10'E. from NW cor. Pleasant Robinette DLC #60.

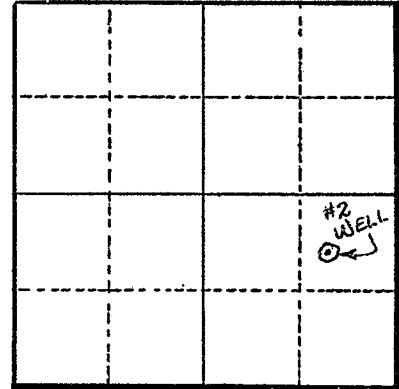

Section 36

Altitude at well 215'

TYPE OF WELL: Drilled Date Constructed 1947

Depth drilled 28' Depth cased 28'

CASING RECORD:
8"

FINISH:

Slot perforations from 18 to 28 ft.

AQUIFERS:

WATER LEVEL:

13'

PUMPING EQUIPMENT: Type F. M. 3" Cent. H.P. 15
Capacity 400 G.P.M.

WELL TESTS:

Drawdown 10 ft. after _____ hours 400 G.P.M.
Drawdown _____ ft. after _____ hours _____ G.P.M.

USE OF WATER Irrigation Temp. _____ °F. _____, 19

SOURCE OF INFORMATION GR Record

DRILLER or DIGGER Bill Hamilton

ADDITIONAL DATA:

Log N.A. Water Level Measurements _____ Chemical Analysis _____ Aquifer Test _____

REMARKS:

Irrigation of 27.3 acres.