

STATE ENGINEER
Salem, Oregon

LINN Well Record

8851

STATE WELL NO. 11/5W-36C
COUNTY LINN
APPLICATION NO. GR-2383

OWNER: Grover C. Smith


MAILING ADDRESS: Rt. 4, Box 303,

LOCATION OF WELL: Owner's No. _____

CITY AND STATE: Corvallis, Oregon

NE $\frac{1}{4}$ NW $\frac{1}{4}$ Sec. 36 T. 11 S., R. 5 W., W.M.

Bearing and distance from section or subdivision corner 1025' S. and 270' W.

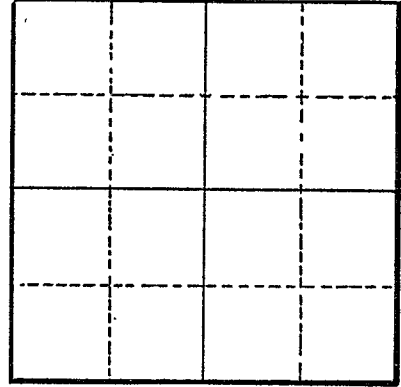

Section _____

Altitude at well _____

TYPE OF WELL: Dug Date Constructed 1935

Depth drilled 34 Depth cased 34

CASING RECORD:

30-inch

FINISH:

AQUIFERS:

WATER LEVEL:

17-feet

PUMPING EQUIPMENT: Type Economy 8" Turbine H.P. 15
Capacity 1000 G.P.M.

WELL TESTS:

Drawdown _____ ft. after _____ hours _____ G.P.M.
Drawdown _____ ft. after _____ hours _____ G.P.M.

USE OF WATER Irrigation Temp. _____ °F. _____, 19_____

SOURCE OF INFORMATION GR-2265

DRILLER or DIGGER Grover C. Smith, Rt. 4, Box 303, Corvallis, Oregon

ADDITIONAL DATA:

Log _____ Water Level Measurements _____ Chemical Analysis _____ Aquifer Test _____

REMARKS: