

STATE ENGINEER
Salem, Oregon

LINN Well Record

8853 GR- 1671

STATE WELL NO. 11/5W-36R
COUNTY Linn
APPLICATION NO. GR- 1722

OWNER: Robert E. Taylor


MAILING ADDRESS: Rt. 4, Box 319

LOCATION OF WELL: Owner's No. #2

CITY AND STATE: Corvallis, Oregon

SE 1/4 SE 1/4 Sec. 36 T. 11 S., R. 5 W., W.M.

Bearing and distance from section or subdivision
corner 688' W. & 425' N. from SE cor. Sec. 36

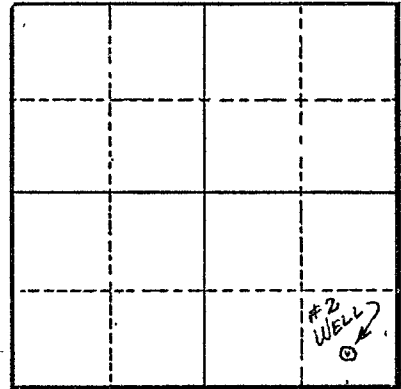

Section 36

Altitude at well 220'

TYPE OF WELL: Drilled Date Constructed 1940

Depth drilled 36' Depth cased 36'

CASING RECORD:
4"

FINISH:
Perforated from 28 to 36 ft.

AQUIFERS:

WATER LEVEL:
10'

PUMPING EQUIPMENT: Type 3" x 2 1/2" Cent. H.P. 10
Capacity 350 G.P.M.

WELL TESTS:
Drawdown ft. after hours G.P.M.
Drawdown ft. after hours G.P.M.

USE OF WATER Irrigation Temp. °F., 19

SOURCE OF INFORMATION GR Record

DRILLER or DIGGER Frank Skillings

ADDITIONAL DATA:
Log N.A. Water Level Measurements Chemical Analysis Aquifer Test

REMARKS:
Irrigation of 6 acres.