

STATE ENGINEER  
Salem, Oregon

LINN  
8854

# Well Record

STATE WELL NO. 11/5W-36R  
COUNTY Linn  
APPLICATION NO. GR-1666

GR- 1617

OWNER: Robert & Pauline Beach


MAILING ADDRESS: Rt. 4

LOCATION OF WELL: Owner's No. #1

CITY AND STATE: Corvallis, Oregon

SE 1/4 SE 1/4 Sec. 36 T. 11 S., R. 5 W., W.M.

Bearing and distance from section or subdivision corner 12 ch. N. 62'30"E. from NW cor. of Pleasant Robinette DLC #60

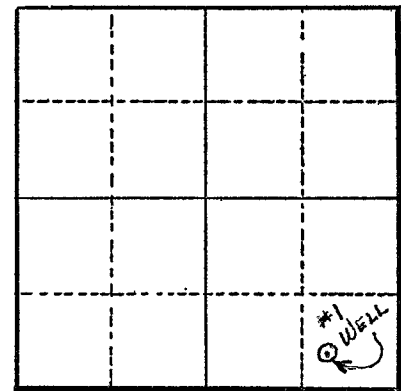

Section 36

Altitude at well 215'

TYPE OF WELL: Drilled Date Constructed 1946

Depth drilled 30' Depth cased 30'

### CASING RECORD:

6"

### FINISH:

Slot perforations from 20 to 30 ft.

### AQUIFERS:

### WATER LEVEL:

7'

PUMPING EQUIPMENT: Type F. M. 2" Cent. H.P. 7 1/2

Capacity 250 G.P.M.

### WELL TESTS:

Drawdown 6 ft. after 300 hours G.P.M.

Drawdown \_\_\_\_\_ ft. after \_\_\_\_\_ hours G.P.M.

USE OF WATER Irrigation Temp. °F. \_\_\_\_\_, 19

SOURCE OF INFORMATION GR Record

DRILLER or DIGGER Bill Hamilton

### ADDITIONAL DATA:

Log N.A. Water Level Measurements \_\_\_\_\_ Chemical Analysis \_\_\_\_\_ Aquifer Test \_\_\_\_\_

### REMARKS:

Irrigation of 14.4 acres