

STATE ENGINEER
Salem, Oregon

LINN
9116

Well Record

GR- 1686

STATE WELL NO. 12/1W-7M
COUNTY Linn
APPLICATION NO. GR- 1738

OWNER: Harry & Lydia B. Gindhart
MAILING ADDRESS: Rt. 3, Box 157A

LOCATION OF WELL: Owner's No. CITY AND STATE: Lebanon, Oregon

NW 1/4 SW 1/4 Sec. 7 T. 12 S. R. 1 W. W.M.

Bearing and distance from section or subdivision
corner 1400' N. & 400' E. from SW cor. Sec. 7


Altitude at well 350'

TYPE OF WELL: Drilled Date Constructed 1947

Depth drilled 64' Depth cased 6'

CASING RECORD:

6" from 0 to 6', the rest rock

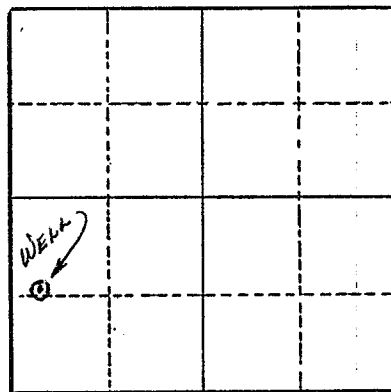

Section 7

FINISH:

AQUIFERS:

WATER LEVEL:

30'

PUMPING EQUIPMENT: Type Jacuzzi Deep Well Turbine H.P. 5
Capacity 60 G.P.M.

WELL TESTS:

Drawdown 15 ft. after hours 55 G.P.M.

Drawdown ft. after hours G.P.M.

USE OF WATER Irrigation Temp. °F. 19

SOURCE OF INFORMATION GR Record

DRILLER or DIGGER

ADDITIONAL DATA:

Log Water Level Measurements Chemical Analysis Aquifer Test

REMARKS:

Log: Soil 0 to 6 ft.
Rock 6 to 64 ft.

Irrigation of 9 acres.