

STATE ENGINEER  
Salem, Oregon

LINN  
9137

Well Record

STATE WELL NO. 12/LW-8H  
COUNTY Linn  
APPLICATION NO. GR-2116

OWNER: Lee & Betty Scott


MAILING ADDRESS: Rt. 3, Box 169

LOCATION OF WELL: Owner's No.

CITY AND STATE: Lebanon, Oregon

SE 1/4 NE 1/4 Sec. 8 T. 12 S., R. 1 W., W.M.

Bearing and distance from section or subdivision corner N. 12° 50' W. 9.3 chs.

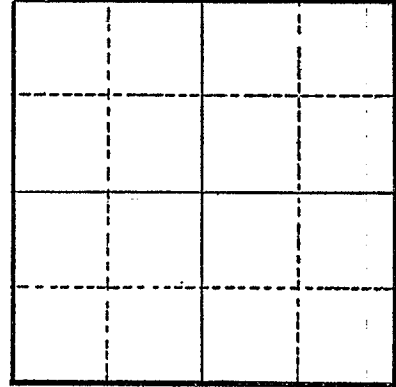

Section

Altitude at well

TYPE OF WELL: drilled Date Constructed 1955

Depth drilled 30 ft. Depth cased 8 ft.

CASING RECORD: 6 inch

FINISH:

AQUIFERS:

WATER LEVEL: 22 ft.

PUMPING EQUIPMENT: Type Jacuzzi jet H.P. 1  
Capacity 35 G.P.M.

WELL TESTS:  
Drawdown 22 ft. after hours pumping 25 G.P.M.  
Drawdown ft. after hours G.P.M.

USE OF WATER irrigation Temp. °F. 19

SOURCE OF INFORMATION GR-2034

DRILLER or DIGGER B. & P. Drilling Co.; Hiatt St., Lebanon, Oregon

ADDITIONAL DATA:

Log Water Level Measurements Chemical Analysis Aquifer Test

REMARKS: