

STATE ENGINEER
Salem, Oregon

LINN
9170

Well Record

STATE WELL NO. 12/1W-10C
COUNTY LINN
APPLICATION NO. GR-2987

OWNER: Hugh Clark

MAILING
ADDRESS:

Rt. 3, Box 63


LOCATION OF WELL: Owner's No.

CITY AND
STATE:

Lebanon, Oregon

NE 1/4 NW 1/4 Sec. 10 T. 12 N. S. R. 1 E. W., W.M.

Bearing and distance from section or subdivision
corner 825' S. and 1452' E.

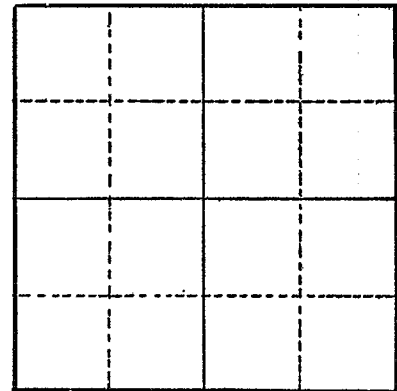

Altitude at well

TYPE OF WELL: Drilled Date Constructed 1946

Depth drilled 146 Depth cased 24

Section

CASING RECORD:

6-inch

FINISH:

AQUIFERS:

WATER LEVEL:

143-feet

PUMPING EQUIPMENT: Type Fairbanks Morse H.P. 5
Capacity G.P.M.

WELL TESTS:

Drawdown 80 ft. after hours Pumping 125 G.P.M.
Drawdown ft. after hours G.P.M.

USE OF WATER Irrigation Temp. °F. 19

SOURCE OF INFORMATION GR-2987

DRILLER or DIGGER Jack Witchcraft, Sweet Home, Oregon

ADDITIONAL DATA:

Log Water Level Measurements Chemical Analysis Aquifer Test

REMARKS: