

STATE ENGINEER
Salem, Oregon

LINN
9323

Well Record

STATE WELL NO. 12/1W-19E(1)
COUNTY Linn
APPLICATION NO. GR-223

OWNER: Robert C. & Blanche H. Sipe


MAILING ADDRESS: 811 Washington St.

LOCATION OF WELL: Owner's No. 1

CITY AND STATE: Albany, Oregon

SW 1/4 NW 1/4 Sec. 19 T. 12 N. S. R. 1 W., W.M.

Bearing and distance from section or subdivision corner N. 35° 45' E. 21 chs. from SW cor. property

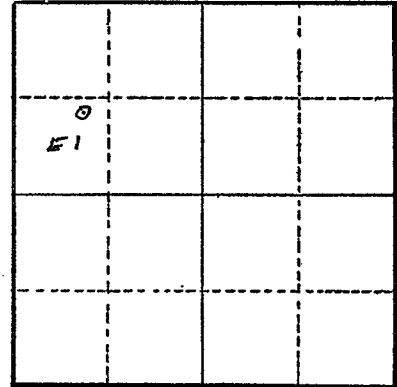

Section 19

Altitude at well 223 ft. Interpolated

TYPE OF WELL: drilled Date Constructed 3/10/52

Depth drilled 23 ft. Depth cased 23 ft.

CASING RECORD: 8 inch casing set from 0 to 23 ft.

FINISH: 12 perforations per foot (3/8" x 3" each) from 18 to 23 ft. filled with gravel.

AQUIFERS: Sand - for total depth of 23 ft.

WATER LEVEL: 14 ft. below land surface 4/12 & 8/25-1952

PUMPING EQUIPMENT: Type Gould 3" x 1/2" Close coupled H.P. 15
Capacity 275 G.P.M.

WELL TESTS:
Drawdown 7 ft. after hours pumping 245 4/12/52 G.P.M.
Drawdown 7? ft. after hours pumping 180 8/25/52 G.P.M.

USE OF WATER irrigation 32.3 acres Temp. °F. 19

SOURCE OF INFORMATION Reg. St. GR-223

DRILLER or DIGGER Art Clinton; Independence, Oregon

ADDITIONAL DATA:

Log No Water Level Measurements Chemical Analysis Aquifer Test

REMARKS: Sand all the way down to bedrock