

STATE ENGINEER
Salem, Oregon

Well Record

STATE WELL NO. 12/LW-19F
COUNTY LINN
APPLICATION NO. GR-2855

LINN
9324

OWNER: J. J. Cramer

MAILING ADDRESS:

Rt. 1, Box 43 C.,


LOCATION OF WELL: Owner's No.

CITY AND STATE:

Lebanon, Oregon

SE 1/4 NW 1/4 Sec. 19 T. 12 N. R. 1 E. W.M.

Bearing and distance from section or subdivision corner 2673' N. and 2376' E.

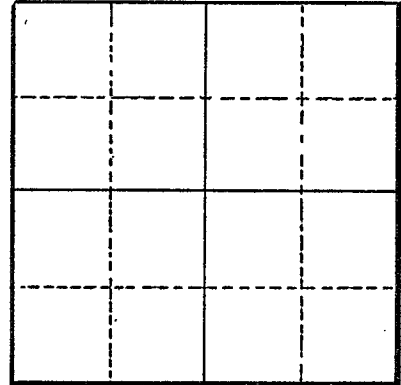

Section

Altitude at well

TYPE OF WELL: drilled Date Constructed 1949

Depth drilled 81 Depth cased 20

CASING RECORD:

6-inch

FINISH:

AQUIFERS:

WATER LEVEL:

PUMPING EQUIPMENT: Type Myers Centrifugal H.P. 1 1/2
Capacity 20 G.P.M.

WELL TESTS:

Drawdown ft. after hours G.P.M.
Drawdown ft. after hours G.P.M.

USE OF WATER irrigation Temp. °F. 19

SOURCE OF INFORMATION GR-2689
DRILLER or DIGGER Rucker and Pyle, Lebanon, Oregon

ADDITIONAL DATA:

Log Water Level Measurements Chemical Analysis Aquifer Test

REMARKS: