

STATE ENGINEER
Salem, Oregon

LINN
9464


Well Record

STATE WELL NO. 12/1W-26E
COUNTY LINN
APPLICATION NO. GR-1965

OWNER: Lyle and Allegra Johnson
MAILING ADDRESS: Rt. 3, Box 7
CITY AND STATE: Lebanon, Oregon

LOCATION OF WELL: Owner's No.
SW 1/4 NW 1/4 Sec. 26 T. 12 N. S. R. 1 E. W. W.M.

Bearing and distance from section or subdivision
corner 2244' S. and 924' E.

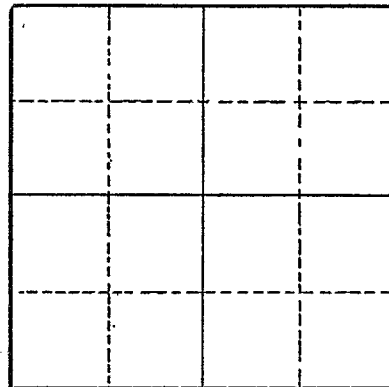

Altitude at well

TYPE OF WELL: Drilled Date Constructed 1953

Depth drilled 60 Depth cased 60

Section

CASING RECORD:

6-inch

FINISH:

Perforations from 50 to 60

AQUIFERS:

Not available

WATER LEVEL:

8-feet

PUMPING EQUIPMENT: Type Downward Ejector H.P. 2
Capacity 40 G.P.M.

WELL TESTS:

Drawdown 48 ft. after hours Pumping 39.75 G.P.M.
Drawdown ft. after hours G.P.M.

USE OF WATER Irrigation Temp. °F. 19

SOURCE OF INFORMATION GR-1896

DRILLER or DIGGER B. & P. Drilling Co., Lebanon, Oregon

ADDITIONAL DATA:

Log Water Level Measurements Chemical Analysis Aquifer Test

REMARKS: