

STATE ENGINEER
Salem, Oregon

LINN
9526

Well Record

STATE WELL NO. 12/1W-28N
COUNTY LINN
APPLICATION NO. GR-2299

OWNER: Lyle Bowers


MAILING ADDRESS: Rt. 1, Box W 48

LOCATION OF WELL: Owner's No.

CITY AND STATE: Lebanon, Oregon

SW 1/4 SW 1/4 Sec. 28 T. 12 S., R. 1 E. W., W.M.

Bearing and distance from section or subdivision corner N. 71° E. 16 chains

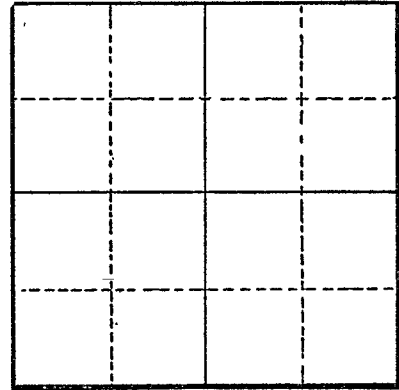

Section

Altitude at well

TYPE OF WELL: Dug Date Constructed 1952

Depth drilled 19 Depth cased 19

CASING RECORD:

4 1/2' X 5 1/2'

FINISH:

Wood casing

AQUIFERS:

WATER LEVEL:

7-feet

PUMPING EQUIPMENT: Type A - Myers Centrifugal 1 1/4" X 3/4" Capacity 120 G.P.M. H.P. 3/4
Type B - Wade Centrifugal 3" X 4" H.P. 7

WELL TESTS:

Drawdown 5 ft. after hours Pumping 112 G.P.M.
Drawdown ft. after hours G.P.M.

USE OF WATER Irrigation Temp. °F., 19

SOURCE OF INFORMATION GR-2194

DRILLER or DIGGER Lyle Bowers

ADDITIONAL DATA:

Log Water Level Measurements Chemical Analysis Aquifer Test

REMARKS: