

STATE ENGINEER
Salem, Oregon

LINN
9782

Well Record


STATE WELL NO. 12/1W-33D
COUNTY LINN
APPLICATION NO. GR-2532

OWNER: Homer F. Guinn and Josephine L. Guinn Mailing ADDRESS: Rt. 1, Box W. 42, Lebanon,

LOCATION OF WELL: Owner's No. CITY AND STATE: Oregon

NW 1/4 NW 1/4 Sec. 33 T. 12 S., R. 1 W., W.M.

Bearing and distance from section or subdivision corner 495' S. and 759' E.

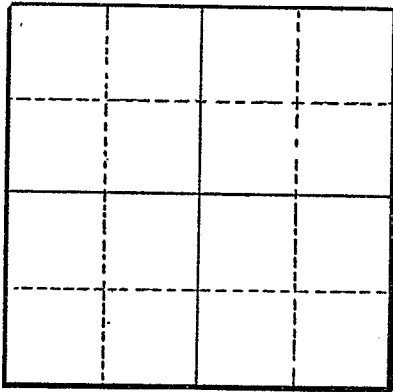

Section

Altitude at well

TYPE OF WELL: drilled Date Constructed 1952

Depth drilled 68 Depth cased

CASING RECORD:

FINISH:

AQUIFERS:

WATER LEVEL:

10-feet

PUMPING EQUIPMENT: Type Sears - Roebuck H.P. 1
Capacity 12 G.P.M.

WELL TESTS:

Drawdown 40 ft. after hours Pumping 15 G.P.M.
Drawdown ft. after hours G.P.M.

USE OF WATER irrigation Temp. °F., 19

SOURCE OF INFORMATION GR-2538

DRILLER or DIGGER

ADDITIONAL DATA:

Log Water Level Measurements Chemical Analysis Aquifer Test

REMARKS: