

STATE ENGINEER
Salem, Oregon

LINN
9988

Well Record


STATE WELL NO. 12/2W-27J
COUNTY LINN
APPLICATION NO. GR-2857

OWNER: William P. and Reta M. Forbes
MAILING ADDRESS: Rt. 2, Box 186

LOCATION OF WELL: Owner's No.
CITY AND STATE: Lebanon, Oregon

NE 1/4 SE 1/4 Sec. 27 T. 12 S., R. 2 W., W.M.

Bearing and distance from section or subdivision
corner 1914' N. and 1000' W.

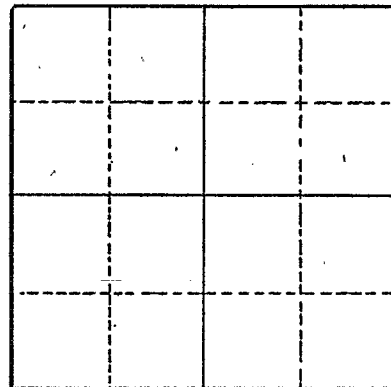

Altitude at well

TYPE OF WELL: Drilled Date Constructed 1951

Depth drilled 27 Depth cased 27

Section

CASING RECORD:

10-inch

FINISH:

Slot perforations from 20 to 27

AQUIFERS:

WATER LEVEL:

8-feet

PUMPING EQUIPMENT: Type Gould 3" centrifugal H.P. 25
Capacity 350 G.P.M.

WELL TESTS:

Drawdown ft. after hours G.P.M.
Drawdown ft. after hours G.P.M.

USE OF WATER Irrigation Temp. °F. 19

SOURCE OF INFORMATION GR-2691

DRILLER or DIGGER Bill Hamilton Drilling Co., 838 E. Third Ave., Albany, Oregon

ADDITIONAL DATA:

Log Water Level Measurements Chemical Analysis Aquifer Test

REMARKS: