

STATE ENGINEER  
Salem, Oregon

*Malh  
010*

OBSERVATION WELL  
Well Record

*Malh 010*


STATE WELL NO. 14/38-28A(1)  
COUNTY Malheur  
APPLICATION NO. U-444

OWNER: Raleigh Van Buren MAILING ADDRESS: Ironside, Oregon

LOCATION OF WELL: Owner's No. 1 CITY AND STATE:

NE 1/4 NE 1/4 Sec. 28 T. 14 N. S., R. 38 E. W., W.M.

Bearing and distance from section or subdivision corner S. 55° W. 1550' from NE cor. of Section 28, T. 14 S., R. 38 E.

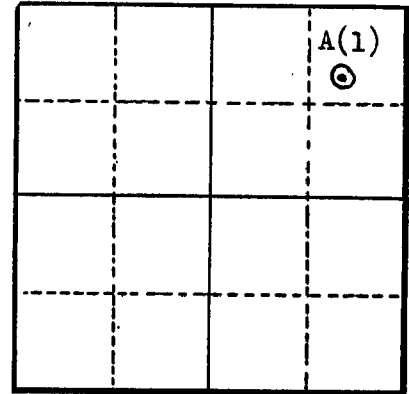

Section 28

Altitude at well

TYPE OF WELL: Date Constructed 2-20-53

Depth drilled 160 Depth cased 150

CASING RECORD:

150' of 12 inch

FINISH:

AQUIFERS:

50 feet

WATER LEVEL:

46 feet

PUMPING EQUIPMENT: Type Capacity G.P.M. H.P.

WELL TESTS:

Drawdown ft. after hours G.P.M.  
Drawdown 73 ft. after 3 3/4 hours 350 G.P.M.

USE OF WATER Irrigation Temp. 60 °F. 9-27-52, 19

SOURCE OF INFORMATION U-444

DRILLER or DIGGER Holloway Drilling Co., Ontario, Oregon

ADDITIONAL DATA:

Log x Water Level Measurements Chemical Analysis Aquifer Test

REMARKS:

Bottom 110 feet perforated



STATE ENGINEER  
Salem, Oregon

*Malh  
010*

*Malh 010 14/38-28A(1)*  
State Well No. ~~31778~~  
County *MALHEUR*  
Application No. *U 444*

### Water Level Record

OWNER: *RALEIGH VAN BUREN* OWNER'S NO. \_\_\_\_\_

Description of measuring point: *Lip of port into casing, 1.5'*  
*Above LSD*

Date	182' - 12"		Date	Remarks	
	Water Level Feet (above) Land Surface	Remarks		Water Level Feet (above) Land Surface	Remarks
<i>10-16-58</i>	<i>43.3</i>	<i>Final Proof Survey</i>			

REMARKS: \_\_\_\_\_  
\_\_\_\_\_  
\_\_\_\_\_