

File Original and First Copy with the STATE ENGINEER, SALEM, OREGON

OCT 31 1960

STATE ENGINEER

WATER WELL REPORT STATE OF OREGON

MALHUE 122

State Well No. 15/42-25B

State Permit No.

(1) OWNER:

Name Mark Velimier Address Oregon One

(2) LOCATION OF WELL:

County MALHUE Owner's number, if any-- NW 1/4 NE 1/4 Section 25 T. 15 R. 42 W.M. Bearing and distance from section or subdivision corner NW 1/4 of the North East corner of the North East 1/4 Sec 25.

(3) TYPE OF WORK (check):

New Well [x] Deepening [] Reconditioning [] Abandon [] If abandonment, describe material and procedure in Item 11.

PROPOSED USE (check):

Domestic [] Industrial [] Municipal [] Irrigation [x] Test Well [] Other []

(5) TYPE OF WELL:

Rotary [] Driven [] Cable [x] Jetted [] Dug [] Bored []

(6) CASING INSTALLED:

10" Diam. from 0 ft. to 34 ft. Gage 44

(7) PERFORATIONS:

Perforated? [x] Yes [] No Type of perforator used SIZE of perforations 1/4 in. by 2 in. 20 perforations from 30 ft. to ft.

(8) SCREENS:

Well screen installed [] Yes [x] No Manufacturer's Name Type Model No. Diam. Slot size Set from ft. to ft. Slot size Set from ft. to ft.

(9) CONSTRUCTION:

Was well gravel packed? [] Yes [x] No Size of gravel: Gravel placed from ft. to ft. Was a surface seal provided? [] Yes [x] No To what depth? ft. Material used in seal-- Did any strata contain unusable water? [] Yes [x] No Type of water? Depth of strata Method of sealing strata off

(10) WATER LEVELS:

Static level 4 ft. below land surface Date 6/15/60 Artesian pressure lbs. per square inch Date

Log Accepted by:

[Signed] M. Velimier (Owner) Date , 19

(11) WELL TESTS:

Drawdown is amount water level is lowered below static level Was a pump test made? [x] Yes [] No If yes, by whom? Yield: 400 gal./min. with 300 ft. drawdown after 10 hrs. Bailer test gal./min. with ft. drawdown after hrs. Artesian flow g.p.m. Date Temperature of water Was a chemical analysis made? [] Yes [x] No

(12) WELL LOG:

Diameter of well 10 inches. Depth drilled 560 ft. Depth of completed well 560 ft. Formation: Describe by color, character, size of material and structure, and show thickness of aquifers and the kind and nature of the material in each stratum penetrated, with at least one entry for each change of formation.

Table with columns MATERIAL, FROM, TO. Entries include top soil, gravel, yellow clay, sandy clay, pebbly gravel, Brown clay, Blue sand, sandy Brown clay, Brown sand stone, sandy Brown clay, pebbly gravel, sandy Brown clay, sandy clay & pebbly gravel.

Work started 19 Completed 19

(13) PUMP:

Manufacturer's Name Type: H.P.

Well Driller's Statement:

This well was drilled under my jurisdiction and this report is true to the best of my knowledge and belief.

NAME H.F. Sevey Drilling (Person, firm, or corporation) (Type or print)

Address Box 176 VAK ONE


Driller's well number

[Signed] Harmon Sevey (Well Driller)

License No. 17 Date , 1960

2572 IV
(HUNTINGTON)

UNITY 43 MI IRONSIDE 24 MI
2 780 000 FEET 117° 30' 44' 15"

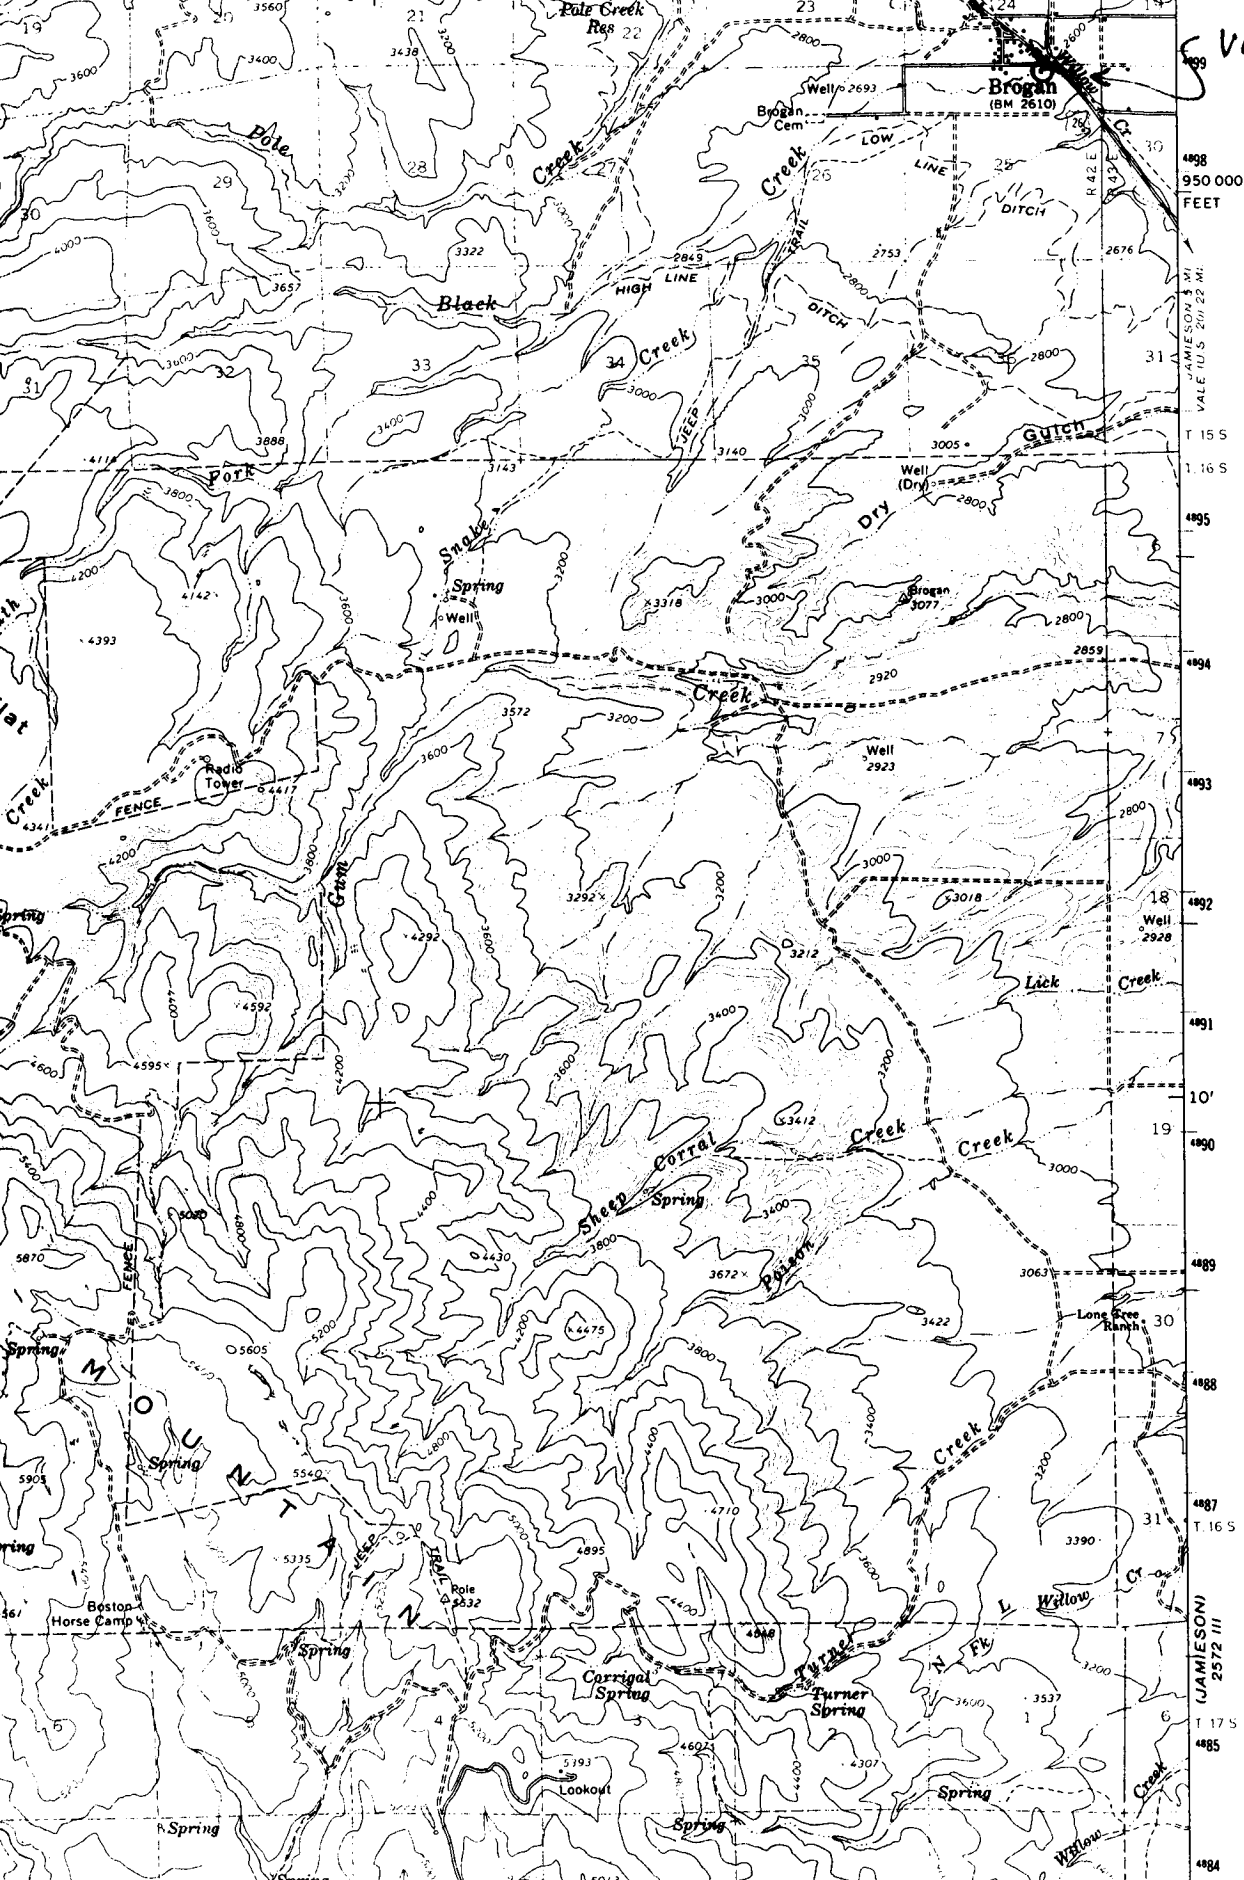

Velsmeyer Well
Obs Net No. 567

4898
950 000
FEET
T 15 S
T 16 S
4895
4894
4893
4892
4891
10'
4890
4889
30
4888
4887
T 16 S
31
4885
T 17 S
4884