

STATE ENGINEER
Salem, Oregon

malheur
1240

Well Record

STATE WELL NO. 18/46-24D(1)
COUNTY Malheur
APPLICATION NO. G-78

OWNER: Lauerence J. Marostica


MAILING ADDRESS: Rt. 1, Ontario, Oregon

LOCATION OF WELL: Owner's No. _____

CITY AND STATE: _____

NW 1/4 NW 1/4 Sec. 24 T. 18 N. S., R. 46 E., W.M.

Bearing and distance from section or subdivision
corner N. 0° 5' W. 1332 ft. from SW cor. SE 1/4 NW 1/4
Sec. 24

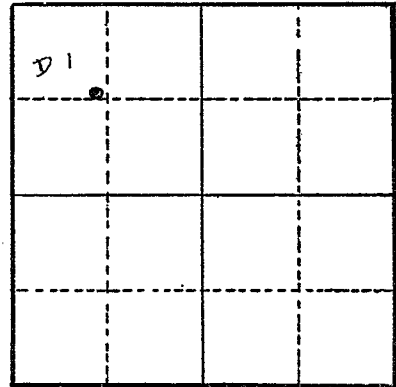

Section 24

Altitude at well _____

TYPE OF WELL: drilled Date Constructed March 1955

Depth drilled 150 ft. Depth cased 44 ft.

CASING RECORD: 1 1/4 inch, set to 44 ft.

FINISH: Perforated from 16 to 38 ft.

AQUIFERS: Gravel from 21 to 42 ft.

WATER LEVEL: 16 ft. below land surface, March 1955

PUMPING EQUIPMENT: Type _____ H.P. _____

Capacity _____ G.P.M.

WELL TESTS:

Drawdown 40 ft. after 4 hours pumping 320 G.P.M.

Drawdown _____ ft. after _____ hours _____ G.P.M.

USE OF WATER irrigation Temp. _____ °F. _____, 19_____

SOURCE OF INFORMATION Well Drillers Report

DRILLER or DIGGER Max Holloway

ADDITIONAL DATA:

Log X Water Level Measurements _____ Chemical Analysis _____ Aquifer Test _____

REMARKS:

