

STATE ENGINEER
Salem, Oregon

Math
128

Well Record

STATE WELL NO. 15/43-30D
COUNTY Malheur
APPLICATION NO. U-353

OWNER: Neil E. Dawson MAILING ADDRESS: _____
LOCATION OF WELL: Owner's No. _____ CITY AND STATE: Brogan, Oregon


NW 1/4 NW 1/4 Sec. 30 T. 15 N. S., R. 43 E. W., W.M.

Bearing and distance from section or subdivision corner _____

Altitude at well _____

TYPE OF WELL: Drilled Date Constructed _____

Depth drilled 120 Depth cased _____

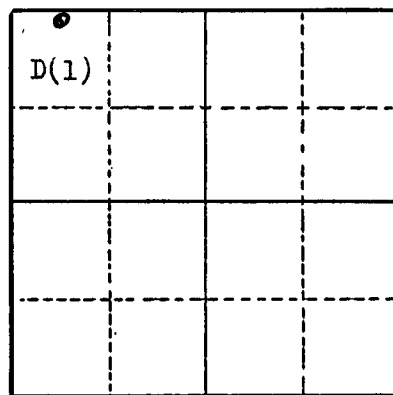

Section 30

CASING RECORD:

6 inch

FINISH:

AQUIFERS:

WATER LEVEL:

Flows

PUMPING EQUIPMENT: Type centrifugal H.P. _____
Capacity _____ G.P.M.

WELL TESTS:

Drawdown _____ ft. after _____ hours _____ G.P.M.
Drawdown _____ ft. after _____ hours _____ G.P.M.

USE OF WATER Irrigation Temp. _____ °F. _____, 19_____

SOURCE OF INFORMATION U-353

DRILLER or DIGGER _____

ADDITIONAL DATA:

Log _____ Water Level Measurements _____ Chemical Analysis _____ Aquifer Test _____

REMARKS: