

STATE ENGINEER  
Salem, Oregon

*Malheur*  
*1285*


# Well Record

STATE WELL NO. 18/47-2N  
COUNTY Malheur  
APPLICATION NO. G-1935

OWNER: Oregon State Highway Comm. MAILING ADDRESS: Oregon State Hwy. Bldg.

LOCATION OF WELL: Owner's No. #1 CITY AND STATE: Salem, Oregon

SW  $\frac{1}{4}$  SW  $\frac{1}{4}$  Sec. 2 T. 18 S., R. 47 W., W.M.  
Bearing and distance from section or subdivision  
corner 65' N. & 55' E. from SW cor. Sec. 2.

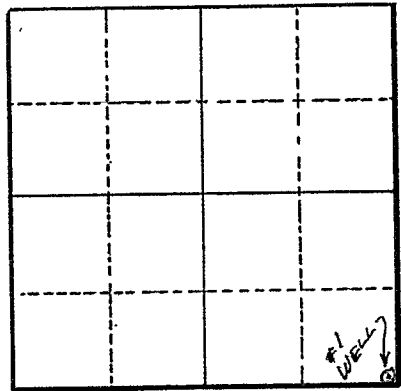

Altitude at well 2100'

TYPE OF WELL: Drilled Date Constructed \_\_\_\_\_  
Depth drilled 37' Depth cased \_\_\_\_\_

Section 2

CASING RECORD:  
12"

FINISH:

AQUIFERS:

WATER LEVEL:  
18'

PUMPING EQUIPMENT: Type 4" Submersible H.P. 5  
Capacity 75 G.P.M.

WELL TESTS:  
Drawdown \_\_\_\_\_ ft. after \_\_\_\_\_ hours \_\_\_\_\_ G.P.M.  
Drawdown \_\_\_\_\_ ft. after \_\_\_\_\_ hours \_\_\_\_\_ G.P.M.

USE OF WATER Irrigation Temp. \_\_\_\_\_ °F. \_\_\_\_\_, 19\_\_\_\_  
SOURCE OF INFORMATION G-1935

DRILLER or DIGGER \_\_\_\_\_  
ADDITIONAL DATA:  
Log N.A. Water Level Measurements \_\_\_\_\_ Chemical Analysis \_\_\_\_\_ Aquifer Test \_\_\_\_\_

REMARKS:  
Irrigation of 7 acres.