

STATE ENGINEER
Salem, Oregon

Math
132

Well Record


Math 13-2

STATE WELL NO. 15/43-31A1
COUNTY Malheur
APPLICATION NO. U-350

OWNER: Eugene D. Smith MAILING ADDRESS: _____
CITY AND STATE: Brogan

LOCATION OF WELL: Owner's No. _____
NE 1/4 NE 1/4 Sec. 31 T. 15 N. S., R. 43 E. W., W.M.

Bearing and distance from section or subdivision corner _____

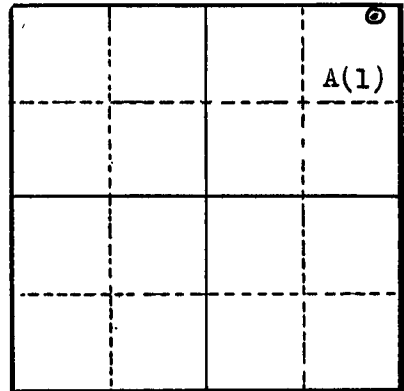

Section 31

Altitude at well _____

TYPE OF WELL: Drilled Date Constructed 1950

Depth drilled 265 Depth cased _____

CASING RECORD:
12 inch to 200 feet
8 inch 200 to 265

FINISH: _____

AQUIFERS: _____

WATER LEVEL:
26 feet in 1950

PUMPING EQUIPMENT: Type submersible H.P. 10
Capacity _____ G.P.M.

WELL TESTS:
Drawdown _____ ft. after _____ hours _____ G.P.M.
Drawdown _____ ft. after _____ hours _____ G.P.M.

USE OF WATER Irrigation Temp. _____ °F. _____, 19____

SOURCE OF INFORMATION H. Sevey

DRILLER or DIGGER _____

ADDITIONAL DATA:
Log Water Level Measurements _____ Chemical Analysis _____ Aquifer Test _____

REMARKS:
Soil 0 to 30
Gravel 30 to 70
Shale 70 to 200
Gravel 200 to 205
Shale & Gravel 205 to 260