

STATE ENGINEER  
Salem, Oregon

*Malheur*  
*1322*

# Well Record


STATE WELL NO. 18/47-3R  
COUNTY Malheur  
APPLICATION NO. G-1935

OWNER: Oregon State Highway Comm. MAILING ADDRESS: Oregon State Hwy. Bldg.

LOCATION OF WELL: Owner's No. #2 CITY AND STATE: Salem, Oregon

SE  $\frac{1}{4}$  SE  $\frac{1}{4}$  Sec. 3 T. 18 S., R. 47 W., W.M.

Bearing and distance from section or subdivision corner 1310' W. & 350' N. from SE cor. Sec. 3.

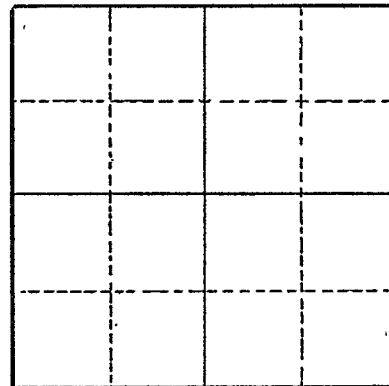

Section 3

Altitude at well 2100'

TYPE OF WELL: Drilled Date Constructed \_\_\_\_\_

Depth drilled 26' 42 Depth cased \_\_\_\_\_

CASING RECORD:  
12"

FINISH:

AQUIFERS:

WATER LEVEL:  
13'

PUMPING EQUIPMENT: Type 4" Submersible H.P. 5  
Capacity 75 G.P.M.

WELL TESTS:  
Drawdown \_\_\_\_\_ ft. after \_\_\_\_\_ hours \_\_\_\_\_ G.P.M.  
Drawdown \_\_\_\_\_ ft. after \_\_\_\_\_ hours \_\_\_\_\_ G.P.M.

USE OF WATER Irrigation Temp. \_\_\_\_\_ °F. \_\_\_\_\_, 19\_\_\_\_

SOURCE OF INFORMATION G-1935

DRILLER or DIGGER \_\_\_\_\_

ADDITIONAL DATA:

Log N.A. Water Level Measurements \_\_\_\_\_ Chemical Analysis \_\_\_\_\_ Aquifer Test \_\_\_\_\_

REMARKS:

Irrigation of 7 acres.

*well 3010 - 38' deep SW 13' 12" dia.*