

STATE ENGINEER  
Salem, Oregon

*Malh*  
*133*

# Well Record

*malh 133*

STATE WELL NO. 15/43-32K(1)  
COUNTY Malheur  
APPLICATION NO. U-200

OWNER: John M. Sholtes

MAILING  
ADDRESS:


LOCATION OF WELL: Owner's No. 2

CITY AND  
STATE:

Brogan, Oregon

NW 1/4 SE 1/4 Sec. 32 T. 15 S., R. 43 W., W.M.

Bearing and distance from section or subdivision  
corner

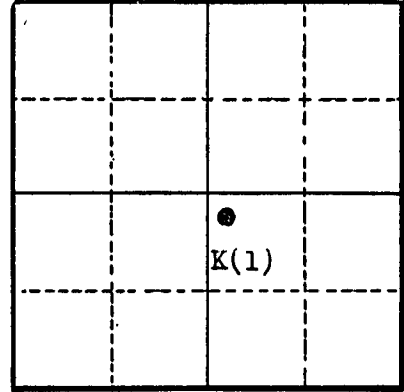

Section 32

Altitude at well

TYPE OF WELL: Drilled Date Constructed 1946

Depth drilled 280 Depth cased

## CASING RECORD:

FINISH:

AQUIFERS:

WATER LEVEL:

21' below land surface

PUMPING EQUIPMENT: Type Turbine H.P. 20  
Capacity G.P.M.

WELL TESTS:

Drawdown ft. after hours G.P.M.

Drawdown ft. after hours G.P.M.

USE OF WATER Irrigation Temp. 51 °F. 7-26, 1949  
SOURCE OF INFORMATION U-200

DRILLER or DIGGER

ADDITIONAL DATA:

Log Water Level Measurements Chemical Analysis Aquifer Test

REMARKS:

