

STATE ENGINEER  
Salem, Oregon

*Malh  
134*

# Well Record

*134*


STATE WELL NO. 15/43-32E(1)  
COUNTY Malheur  
APPLICATION NO. U-369

OWNER: Hideo Harada MAILING ADDRESS: \_\_\_\_\_

LOCATION OF WELL: Owner's No. \_\_\_\_\_ CITY AND STATE: Jamison, Oregon

SW  $\frac{1}{4}$  NW  $\frac{1}{4}$  Sec. 32 T. 15 <sup>N.</sup> S., R. 43 <sup>E.</sup> W., W.M.

Bearing and distance from section or subdivision corner \_\_\_\_\_

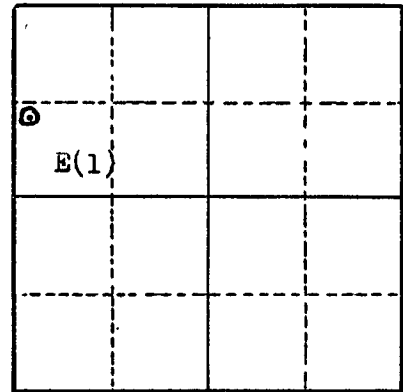

Section \_\_\_\_\_

Altitude at well \_\_\_\_\_

TYPE OF WELL: Drilled Date Constructed 1951

Depth drilled 250 Depth cased \_\_\_\_\_

### CASING RECORD:

12-inch

### FINISH:

### AQUIFERS:

### WATER LEVEL:

30 feet below land surface

PUMPING EQUIPMENT: Type Turbine H.P. \_\_\_\_\_  
Capacity 650 G.P.M.

### WELL TESTS:

Drawdown \_\_\_\_\_ ft. after \_\_\_\_\_ hours \_\_\_\_\_ G.P.M.

Drawdown \_\_\_\_\_ ft. after \_\_\_\_\_ hours \_\_\_\_\_ G.P.M.

USE OF WATER Irrigation Temp. \_\_\_\_\_ °F. \_\_\_\_\_, 19\_\_\_\_\_

SOURCE OF INFORMATION U-369

DRILLER or DIGGER \_\_\_\_\_

### ADDITIONAL DATA:

Log \_\_\_\_\_ Water Level Measurements \_\_\_\_\_ Chemical Analysis \_\_\_\_\_ Aquifer Test \_\_\_\_\_

### REMARKS: