

STATE ENGINEER  
Salem, Oregon

*Malheur 135*

# Well Record

*Malheur 135*


STATE WELL NO. 15/43-32L(1)  
COUNTY Malheur  
APPLICATION NO. U-167

OWNER: John M. Scholtes MAILING ADDRESS: .....

LOCATION OF WELL: Owner's No. 1 CITY AND STATE: Brogan, Oregon

NE 1/4 SW 1/4 Sec. 32 T. 15 S., R. 43 <sup>N.</sup> W., W.M.

Bearing and distance from section or subdivision corner .....

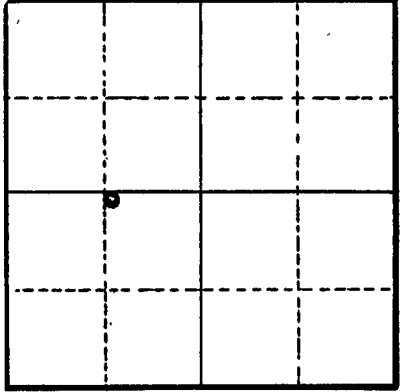

Section 32

Altitude at well .....

TYPE OF WELL: Drilled Date Constructed 1945

Depth drilled 375 Depth cased 97 & 250

### CASING RECORD:

12 inch set to 97'  
8 inch set to 250'

### FINISH:

### AQUIFERS:

### WATER LEVEL:

17 feet below land surface, 1945

PUMPING EQUIPMENT: Type ..... H.P. 15  
Capacity ..... G.P.M.

### WELL TESTS:

Drawdown ..... ft. after ..... hours ..... G.P.M.  
Drawdown ..... ft. after ..... hours ..... G.P.M.

USE OF WATER Irrigation Temp. .... °F. ...., 19.....

SOURCE OF INFORMATION U-167

DRILLER or DIGGER .....

### ADDITIONAL DATA:

Log  Water Level Measurements ..... Chemical Analysis ..... Aquifer Test .....

### REMARKS:

