

STATE ENGINEER
Salem, Oregon

Malheur
1433

Well Record

STATE WELL NO. 18/17-5E(1)
COUNTY Malheur
APPLICATION NO. G-1561

OWNER: Andrew E. Moore

MAILING ADDRESS: 1991 Claggett Lane

LOCATION OF WELL: Owner's No. _____

CITY AND STATE: Ontario, Oregon

SW $\frac{1}{4}$ NW $\frac{1}{4}$ Sec. 5 T. 18 ^{N.} S., R. 17 ^{E.} W., W.M.


Bearing and distance from section or subdivision corner _____

Altitude at well _____

TYPE OF WELL: drilled Date Constructed 1940's

Depth drilled 30 ft. Depth cased 30 ft.

CASING RECORD: 8 inch

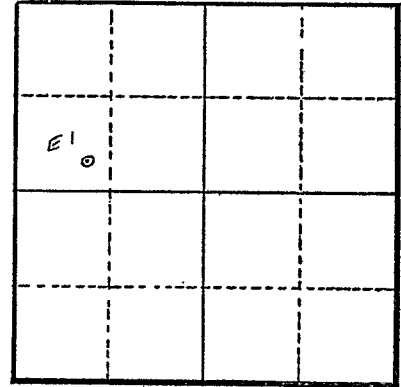

Section 5

FINISH: _____

AQUIFERS: _____

WATER LEVEL: 25 ft.

PUMPING EQUIPMENT: Type _____ H.P. _____
Capacity _____ G.P.M.

WELL TESTS:

Drawdown _____ ft. after _____ hours _____ G.P.M.

Drawdown _____ ft. after _____ hours _____ G.P.M.

USE OF WATER irrigation Temp. _____ °F. _____, 19_____

SOURCE OF INFORMATION _____

DRILLER or DIGGER _____

ADDITIONAL DATA:

Log _____ Water Level Measurements _____ Chemical Analysis _____ Aquifer Test _____

REMARKS: _____