

STATE ENGINEER
Salem, Oregon

Malheur
1519

Well Record

STATE WELL NO. 18/47-7H(1)
COUNTY Malheur
APPLICATION NO. U-493

OWNER: Ted Berreth


MAILING ADDRESS: Rt. 2, Box 708

LOCATION OF WELL: Owner's No. _____

CITY AND STATE: Ontario, Oregon

SE $\frac{1}{4}$ NE $\frac{1}{4}$ Sec. 7 T. 18 ^{N.} S., R. 47 ^{E.} W., W.M.

Bearing and distance from section or subdivision corner 643 ft. N. & 63 ft. W. of E $\frac{1}{4}$ cor. Sec. 7

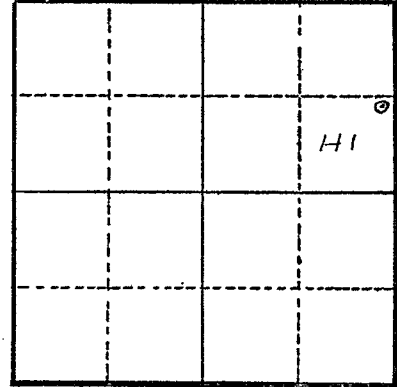

Section 7

Altitude at well _____

TYPE OF WELL: _____ Date Constructed 1948

Depth drilled 55 ft. Depth cased _____

CASING RECORD: 12 inch

FINISH: _____

AQUIFERS: _____

WATER LEVEL: 33 ft. below land surface

PUMPING EQUIPMENT: Type turbine H.P. 3
Capacity 231 G.P.M.

WELL TESTS:

Drawdown _____ ft. after _____ hours _____ G.P.M.

Drawdown _____ ft. after _____ hours _____ G.P.M.

USE OF WATER irrigation Temp. _____ °F. _____, 19 _____

SOURCE OF INFORMATION U-493

DRILLER or DIGGER _____

ADDITIONAL DATA:

Log _____ Water Level Measurements _____ Chemical Analysis _____ Aquifer Test _____

REMARKS: _____