



Oregon Water Resources Department
725 Summer Street NE, Suite A
Salem Oregon 97301
(503) 986-0900
www.wrd.state.or.us

Application for
Well ID Number

RECEIVED

NOV 30 2015

WATER RESOURCES DEPT
SALEM, OREGON

Do not complete if the well already has a Well Identification Number.

I. OWNER INFORMATION

Current Owner Name (please print): OAKES RANCH LLC
Mailing Address: 5126 WILLOW CREEK ROAD
City, State, Zip: IRONSIDE, OR 97908
Mail Well ID Tag to: [X] SAME AS ABOVE [] In Care Of (C/O)
Name & Address:
City, State, Zip:

II. WELL LOCATION INFORMATION (Please fill out as completely as possible)

Township: 14 S (North / South) Range: 39 E (East / West) Section: 15
Tax Lot: County MALHEUR SW 1/4 SW 1/4
GPS Coordinates: LAT: 44.34339 LONG: -117.93080
Street Address of Well, City:
If the property had a different street address in the past:

III. GENERAL WELL INFORMATION (Please fill out as completely as possible)

Use of Well (domestic, irrigation, commercial, industrial, monitoring): IRRIGATION
Date Well Constructed (or property built): 1948-51 Total Well Depth: 860 Casing Diameter: 10"
Owner at time the well was constructed (if known):
Other Information: MALH 016 TAG # L-115398 ATTACHED BY BOB MAYNARD, WELL INSPECTOR

SUBMITTED BY (please print): BOB MAYNARD, E REGION WELL INSPECTOR
PHONE: 541-523-8224 EMAIL &/or FAX:

Send application to: Oregon Water Resources Department 725 Summer St NE, Suite A, Salem, Oregon 97301; or fax to (503) 986-0902. Applications are processed in the order they are received, and Well ID Numbers are mailed within 4-5 business days.

For Official Use Only by the Oregon Water Resources Department:

Received Date:

11-30-15

Well Log Number:

MALH 16

Well Identification #:

L-115398

STATE ENGINEER
Salem, Oregon

Malh 016 MALH 16 *malh 016*
Well Record

STATE WELL NO. 14/39-15N(1)
COUNTY Malheur
APPLICATION NO. U-410
Permit No. 735

OWNER: A. E. Nichols


MAILING ADDRESS: Route 2

LOCATION OF WELL: Owner's No.

CITY AND STATE: Vale, Oregon

SW 1/4 SW 1/4 Sec. 15 T. 14 S. R. 39 W., W.M.

Bearing and distance from section or subdivision corner 232' East and 314' North of SW cor.
Section 15

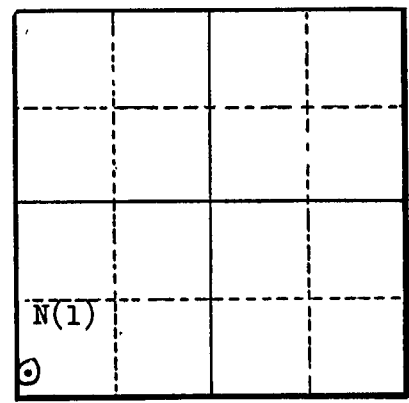

Section 15

Altitude at well

TYPE OF WELL: Drilled Date Constructed 1948-51

Depth drilled 860 Depth cased

CASING RECORD:

10 inch

FINISH:

AQUIFERS:

Broken rock from 856 to 860 feet

WATER LEVEL:

Flows approximately 1800 gpm

PUMPING EQUIPMENT: Type None H.P.
Capacity G.P.M.

WELL TESTS:

Drawdown ft. after hours G.P.M.
Drawdown ft. after hours G.P.M.

USE OF WATER Irrigation Temp. °F., 19

SOURCE OF INFORMATION U-410

DRILLER or DIGGER Max Holloway

ADDITIONAL DATA:

Log x Water Level Measurements Chemical Analysis Aquifer Test

REMARKS:

Flow measured on April 11, 1951 3.3 c.f.s.

