

STATE ENGINEER
Salem, Oregon

Malheur Well Record
18317 Original log in G-90

STATE WELL NO. 19/44-17M(2)
COUNTY Malheur
APPLICATION NO. G-90

OWNER: Anna Mary Robbins


MAILING ADDRESS: Rt. 1, Box 151

LOCATION OF WELL: Owner's No. 2

CITY AND STATE: Vale, Oregon

NW $\frac{1}{4}$ SW $\frac{1}{4}$ Sec. 17 T. 19 N. S., R. 44 E. W., W.M.

Bearing and distance from section or subdivision corner 960 ft. E. & 90 ft. S. of W $\frac{1}{4}$ cor. Sec. 17

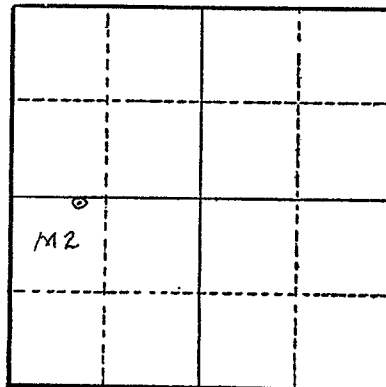

Altitude at well 2243 ft.

TYPE OF WELL: drilled Date Constructed Dec. 1955

Depth drilled 58 ft. Depth cased 58 ft.

Section 17

CASING RECORD: 12 inch, set to 58 ft.

FINISH: Perforations from 38 to 58 ft.

AQUIFERS: Gravel from 38 to 58 ft.

WATER LEVEL: 33 ft. below land surface, December 1955

PUMPING EQUIPMENT: Type _____ H.P. _____
Capacity _____ G.P.M.

WELL TESTS:
Drawdown 30 ft. after 13 hours pumping 550 G.P.M.
Drawdown _____ ft. after _____ hours _____ G.P.M.

USE OF WATER irrigation Temp. 58 °F. _____ December, 1955

SOURCE OF INFORMATION Well Drillers Report

DRILLER or DIGGER H. A. Sevey

ADDITIONAL DATA:

Log Water Level Measurements _____ Chemical Analysis _____ Aquifer Test _____

REMARKS:

